


2.6	5.55	11.00
	1.47	5.58
	4.08	5.45

Patented by John Martin.

S. E. 1/4 Sec. 23 T 6
N - R - 2 W.

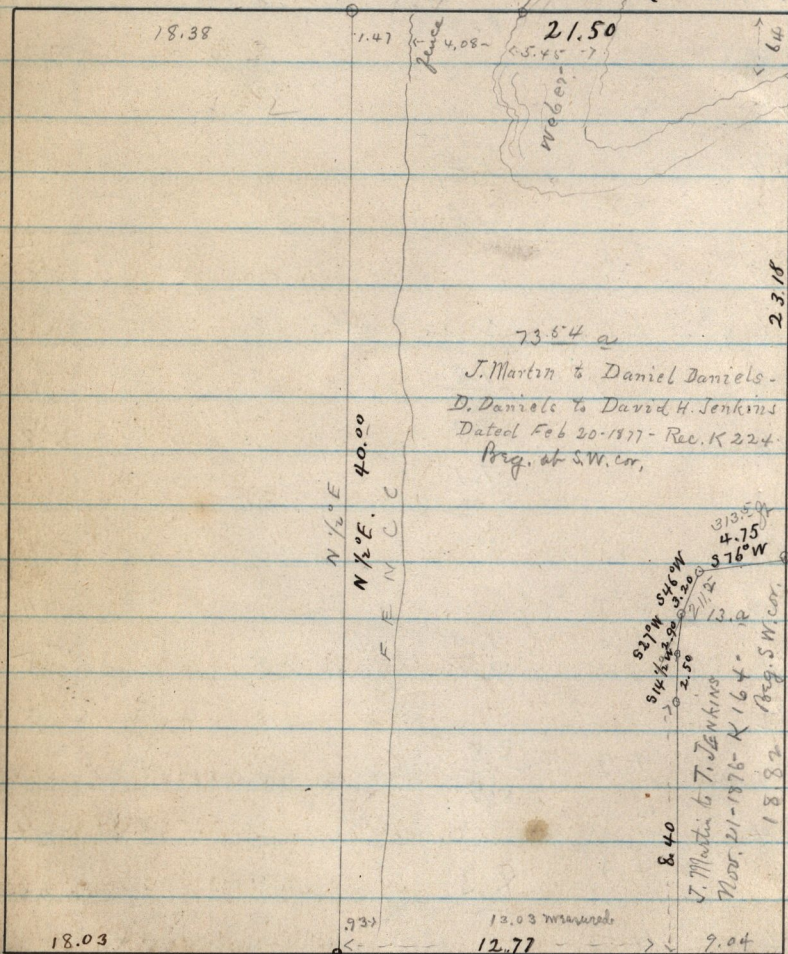

measured length of S. line said $\frac{1}{4} = 40$ chains
 corrected measurement
 = 39.456 chains with steel chains