Part of SW 1/4 Sec. 16 T-6-
N. R-1 W.

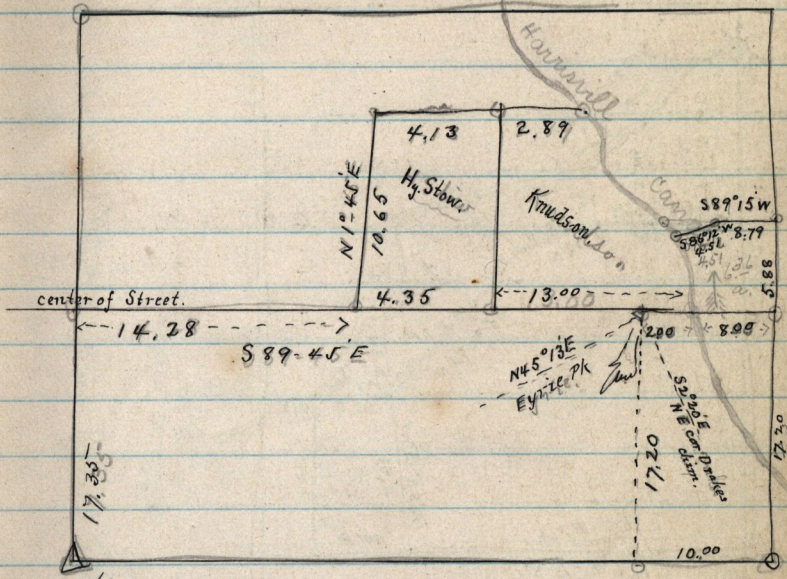
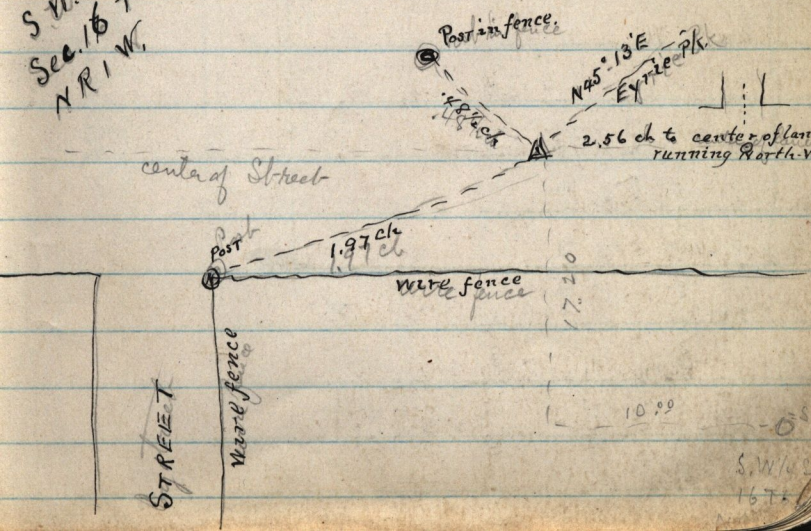
S.W. cor Sec. 16 T 6 N R 1 W.