

97.2
8.80
4.95

N6-04'E
BENLO. PK.

8.22 ch W. from See line
E. LINE 27

S63-29 W
FREMONT.


COUNTY SURVEY MONUMENT
NO 15 NEAR
CEMETERY IN N. OGDEN
IN MAIN ST.

S47-36 E
EYRIE PK.

N4-32 E
BENLO

S41-25 E
EYRIE
S. END Mt. H.S.

COUNTY SURVEY MONT NO 46
SITUATED near the
S.W. cor. N.O. CEMETERY
80 ch E. & 50 ch N. from
N.E. cor. B. 36 - P.A. N.O.
Survey.

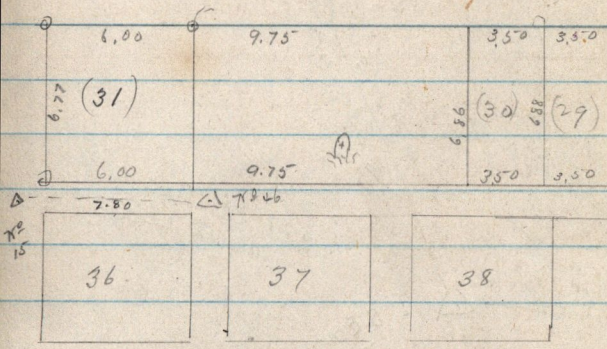

△ = N.E. cor. See 30
T 7 N R 1 W

S51-26 E
Cherry on N.O.
Mt. H.S.

S7-53 E
DAME on
Co. Court
H.S.