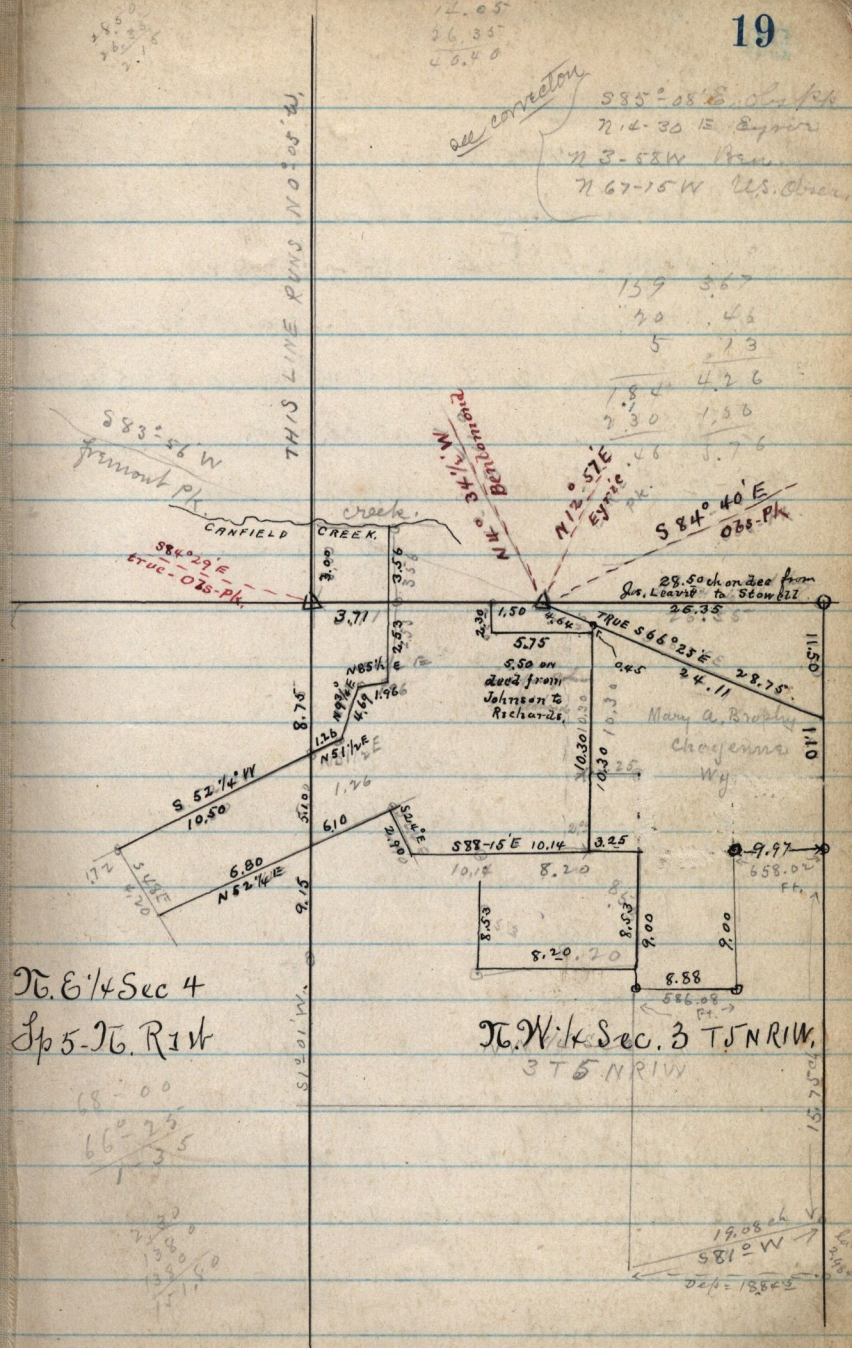
THIS LINE RUNS N 0°-25' W.
Old corrector
S 83°-56' W
Fremont Pk.
CANFIELD CREEK.
creek.
S 84° 29' E
true - 03s - Pk.
3.00
3.56
3.71
S 84° 40' E
03s - Pk.
28.50 on line from Jas. Leavitt to Stowell
26.35
1.50
2.64
2.39
5.75
TRUE S 66° 23' E
24.11
28.75
0.45
5.50 on deed from Johnson to Richards
Mary A. Bradley
Cheyenne
Wy.
N 85¼ E
2.53
N 49¾ E
4.69
1.96
8.75
N 51¼ E
1.26
S 52.¼ W
10.50
6.10
5.10
S 04¼ E
2.90
S 88-15' E 10.14
3.25
9.97
658.02 Ft.
10.15
8.20
6.80
N 52.¼ E
9.15
1.72
S 38¼ E
4.20
8.53
8.53
9.00
2.00
8.20
8.88
586.08 Ft.
N. E¼ Sec 4
Tp 5 - N. R 1 W
N. W¼ Sec. 3 T 5 N R 1 W.
3 T 5 N R 1 W
S 10° W
19.08 ch
S 81° W
18.82 ch