

14.00
13.81
- .19

6.64
7.27
13.81

.19
1.51
1.17
2.17
3.87


13

13.69

37

April 10-1885.

5.00
1.74
1.29
8.03

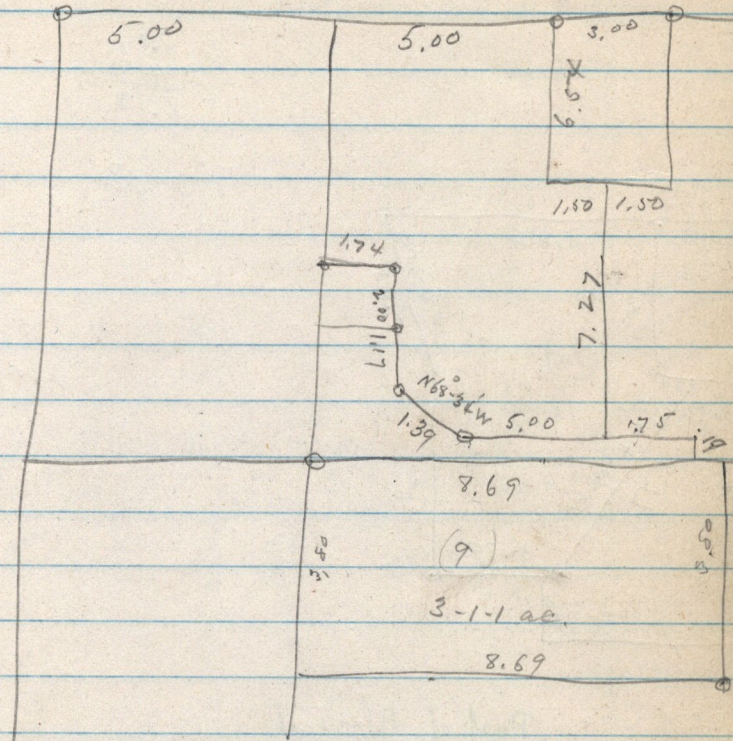

Part of B 4-S-O.S.

13.69