


on Dec. 9 - 1890 the shore **47**
of the lake was about 1 mile farther
west.

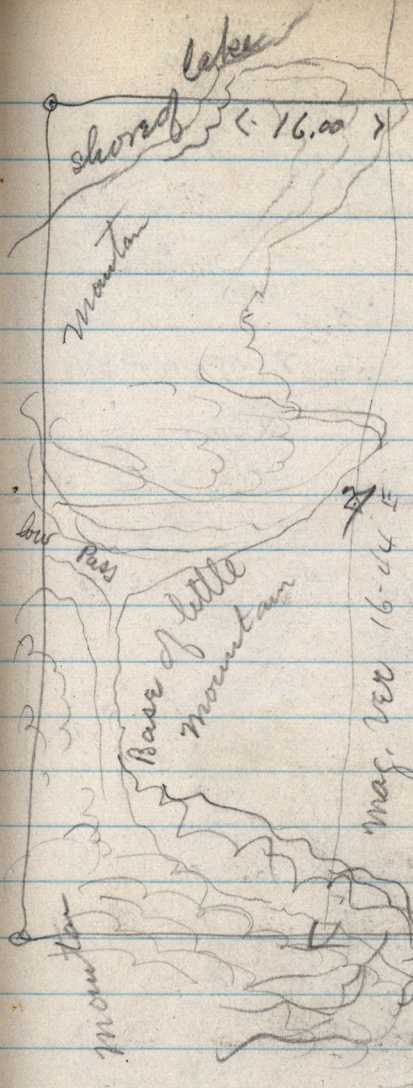

Sec 7 T 6 N R 3 west

The NW 1/4 of Sec 7 contains 136.6 ac.