


SEE Page (157.)

N.W. 1/4 Sec. 26 T 5 N - R 1 W.

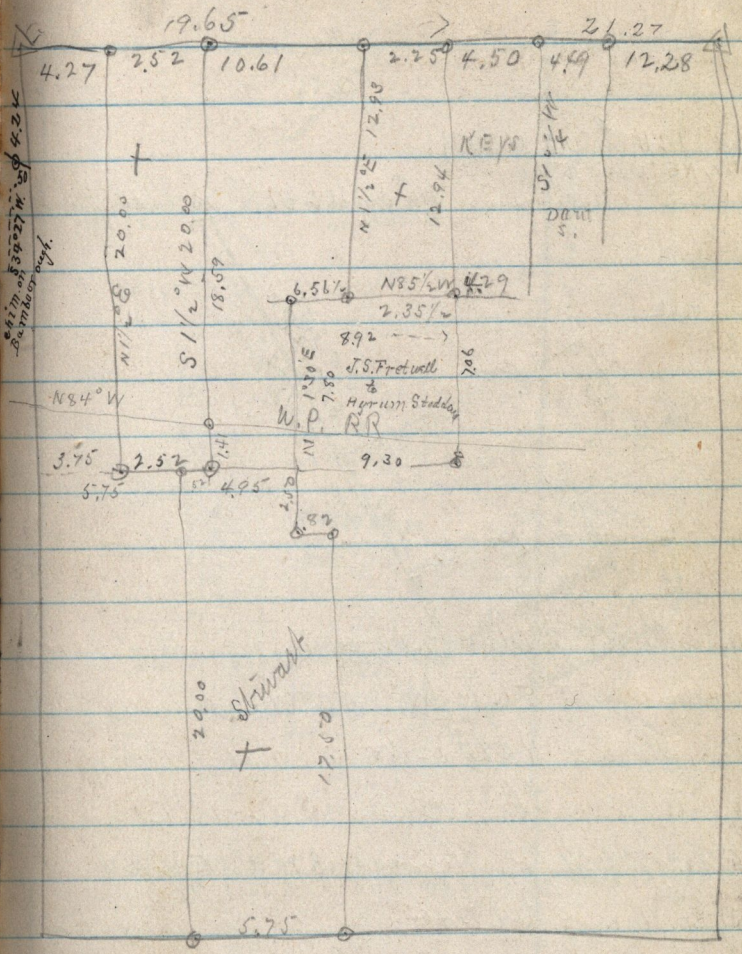

4.27
5.82
10.61
17.40

330
82
2.48

28.55
11.45
9.
2.55

030.55
14.
12.22
30.85
42.72

40.
31.79
8.21

28.60
32.71
7.20
58
12.28

330
92
2.38
4.49
4.49

17.40
3.25
19.65
4.50
4.49
12.28
40.92

31.79
8.21

11.79
28
31.79

11.36
43
11.77

11.36
43
16.79

12.28
43
12.71