Huntsville - Utah July 2 - 1885
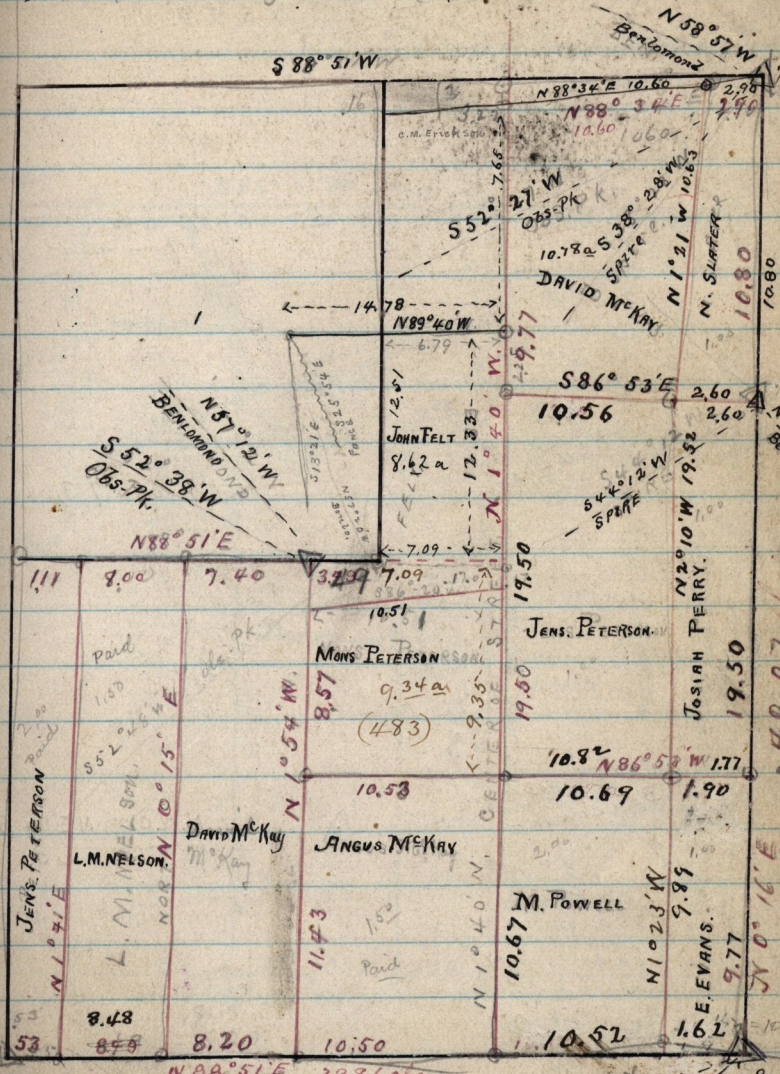
S. E. ¼ Sec 7 T 6 N R 2 East S. L. M.