


July 7-1885-

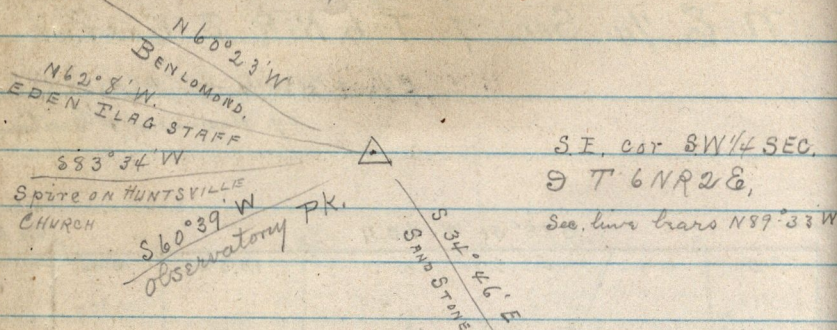

S.E. cor SW $\frac{1}{4}$ SEC.
 9 T 6 N R 2 E,
 Sec. line bears $N 89^{\circ} 33' W$

