


Huntville July 7-1885

S.W. 1/4 Sec 9 T. 6. N. R. 2. E.

SE 1/4 of SW 1/4 HAMMOND & GEERTSON

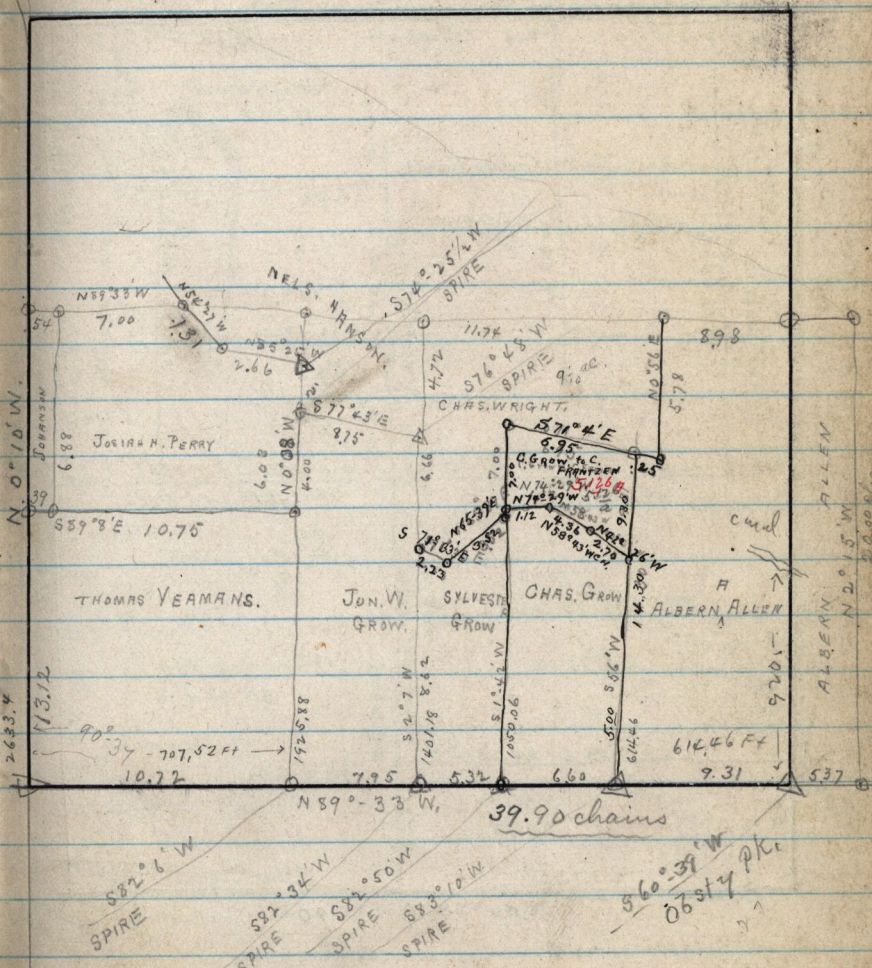

Mrs Johansen 1.00 Josiah Perry 2.00 Nels Hansen 2.00 John
 Paid
 d Grow 1.50 Chas Wright 2.00 T Yeamans 1.50 Sylvester Grow
 1.50 Charles Grow 1.50 Alberrn A. Allen 1.50 Strumby 1.00