


S. W. 1/4 Sec 6 T. 12 R. 2 E

SE 1/4 of above by ^{W.} Nils Mathisen
 SW 1/4 of " " " " Jorgén H. Rosmusse
 22.75 a

1/2 in.

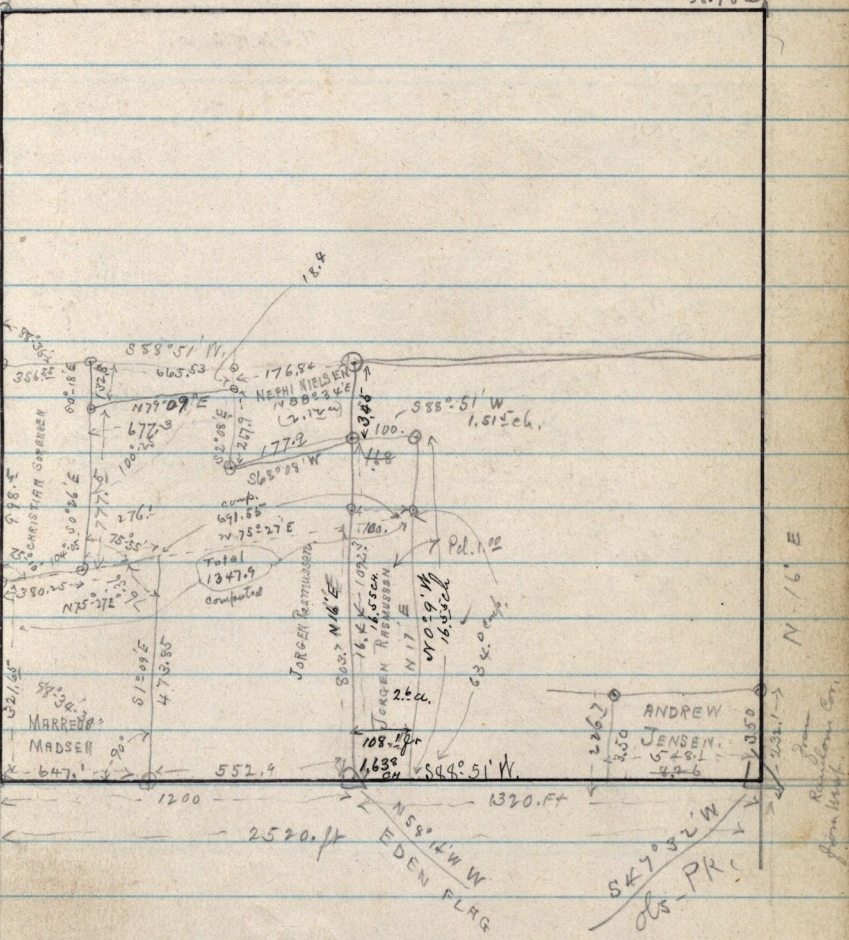

528/2

21
 20
 10
 10