


Huntsville July 8-1885-
 N.W. 1/4 Sec 7 T 6 N R 2 E.

Hammond & Coertson

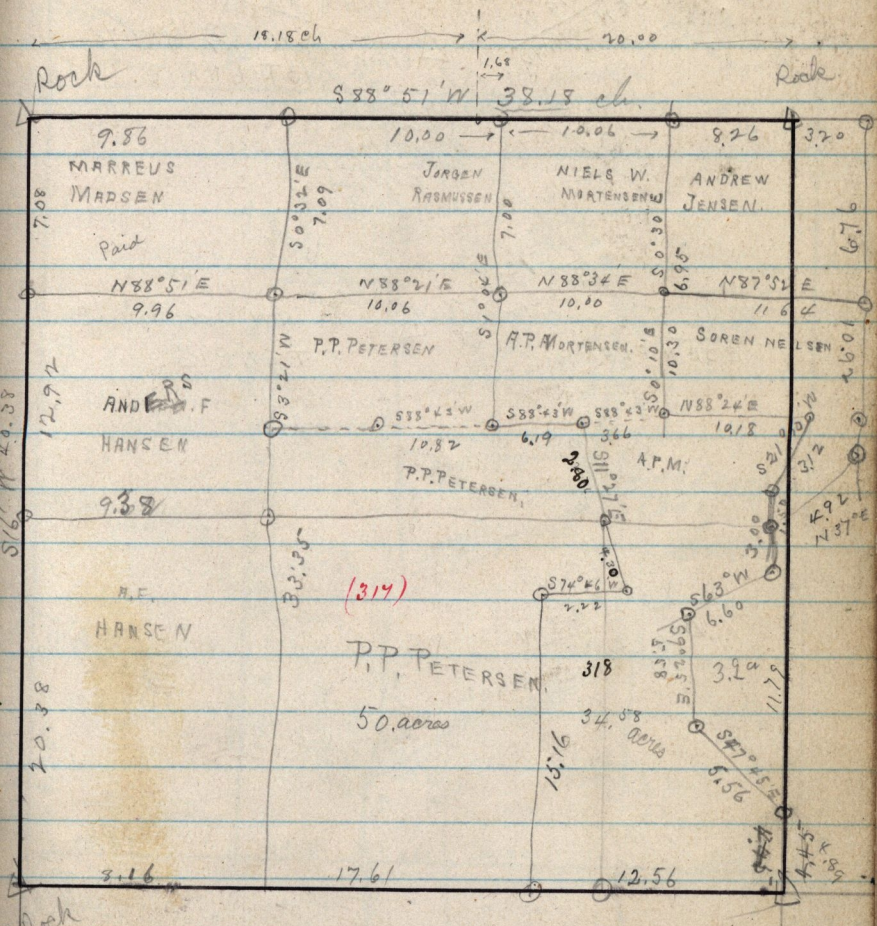

Marreus Madsen ^{Paid} 1.50 J. Rasmussen 1.50 Niele Mortensen 1.50
 Andrew Jensen ^{Paid} 2.00 Soren Nelson 1.75 A.P. Mortensen ^(1.50 P.) 2.00
 P.P. Petersen ^{Paid 1.50} 2.00 Anders Hansen ^{Paid} 2.00 = 14.25