88-42
1-14-
89-57

N.W. 1/4 Sec. 13 T 6. N.R I E.

N. W. 1/4 Sec 13 T 6 N R I E.
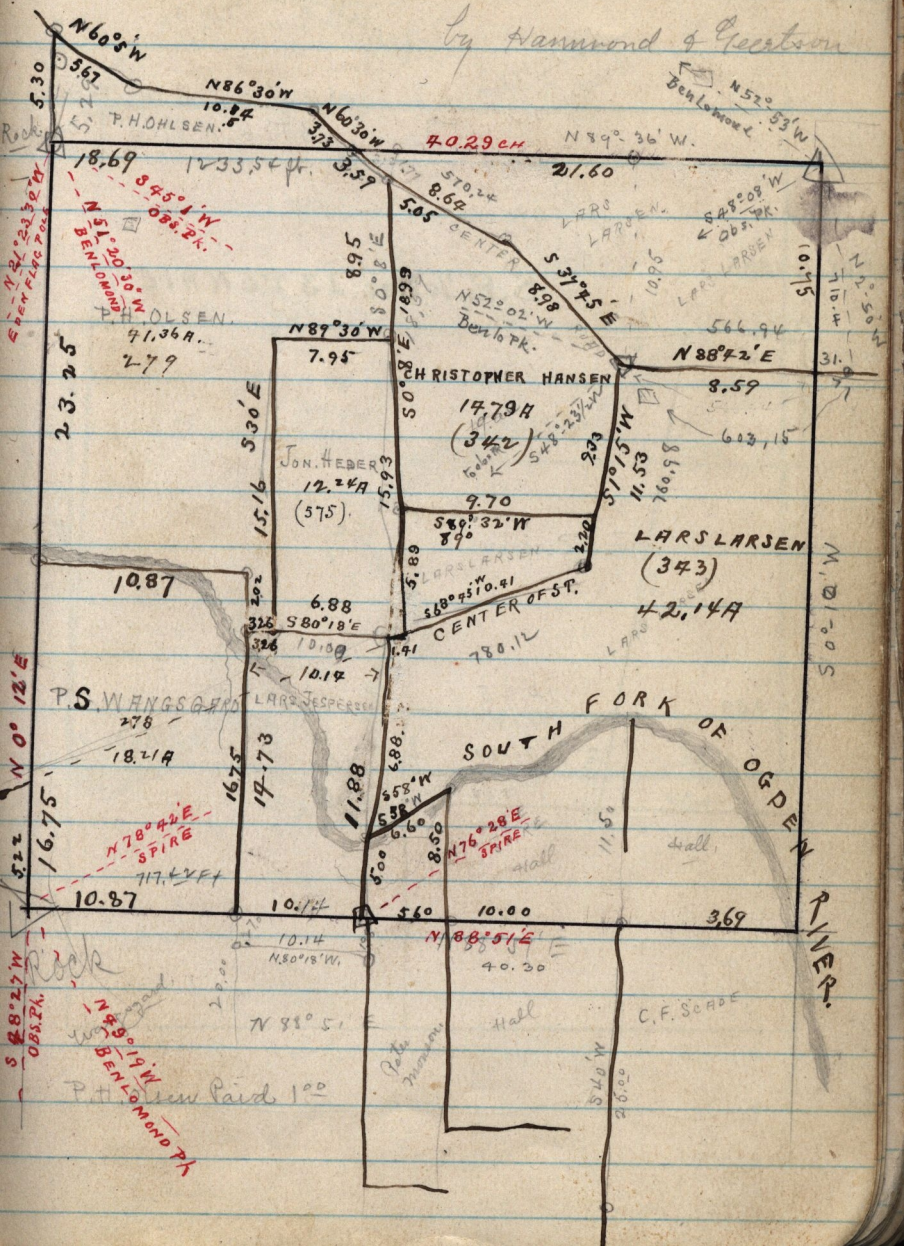
by Hammond & Creetron