

N 1/4 Sec. 17 T6 N R2 E.

N. W. 1/4 Sec 17 T6 N 2 E.

NSO 5.8 W
BENEDICOND
55° 22' W
OBS. PK.
568° W
SPIRE


80° 25' W
SPIRE
40.31 CH

S 0° 05' W

57° 33' E
SPIRE
57° 33' E
SPIRE
557° 58' W
OBS. PK.
N 12° 0' W
SPIRE
51° 15' W
SPIRE

165° 11' W
SPIRE

538° 22' W
OBS. PK.

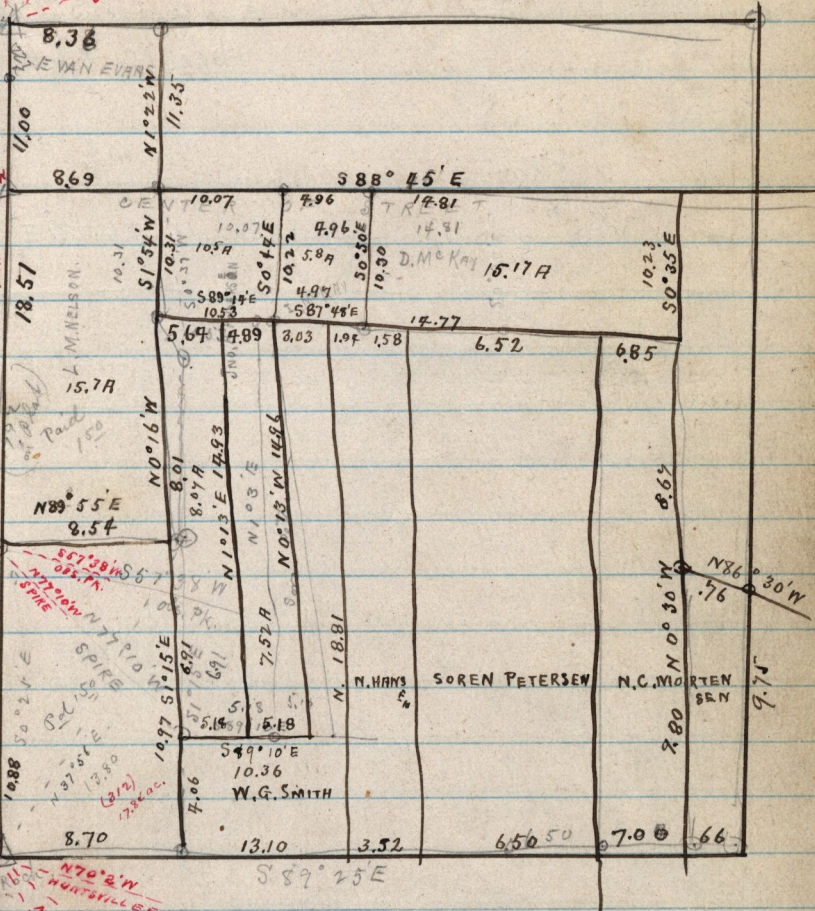

Isaac McKay 1.50
