N52°53'W
Benchmark

= S.E. cor. SW 1/4
Sec 12 T6NR1W

S48° 8'W
ols - PK.

330
.55
2,175
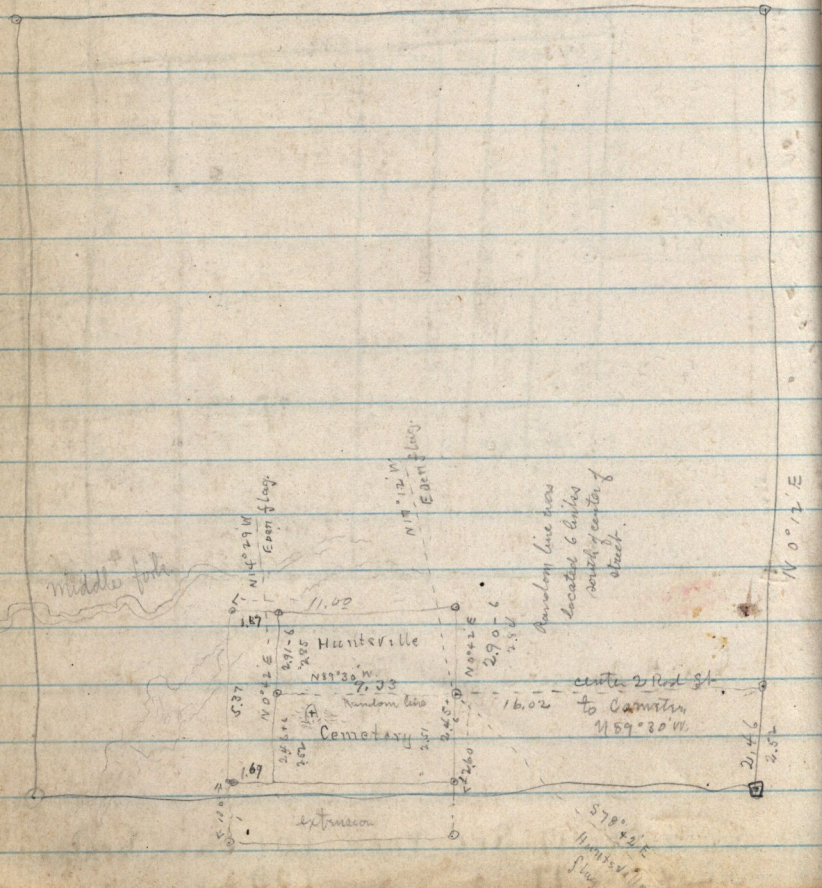
S E 1/4 Sec 11 T6NR1E