


N. E. 1/4 Sec 4 T 5
N. R. 1 W.

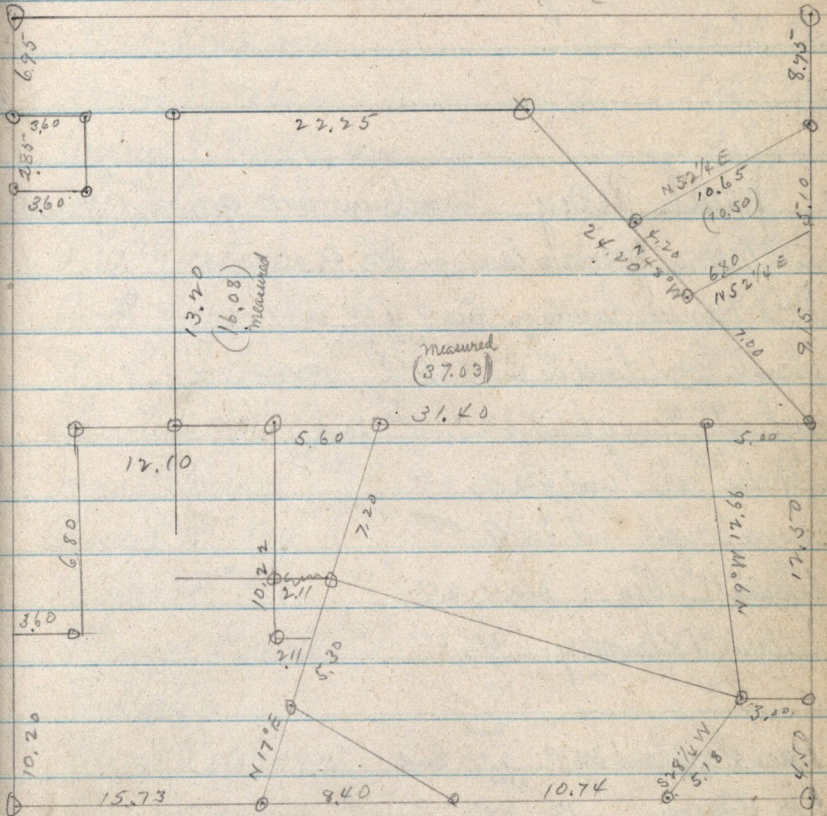

1.78 6.77
1.33 6.28
1.25 6.20