

bearings according to
Magnetic N 16° 45' E.


Noah Shurtliff

Entry -

March 7-1887

N.W. 1/4 Sec. 8 - T6N R1W.

See also page 138

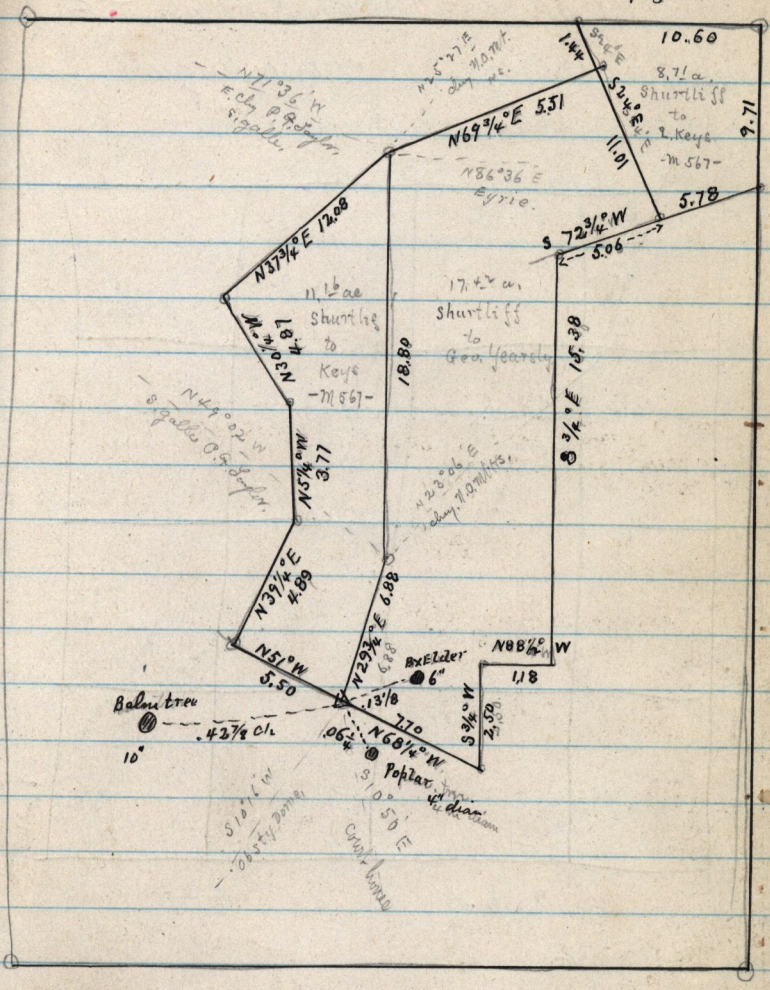

4 43
26 58
10 58
14. 10
10 2
4 43
26 58
26 58
27 25 8