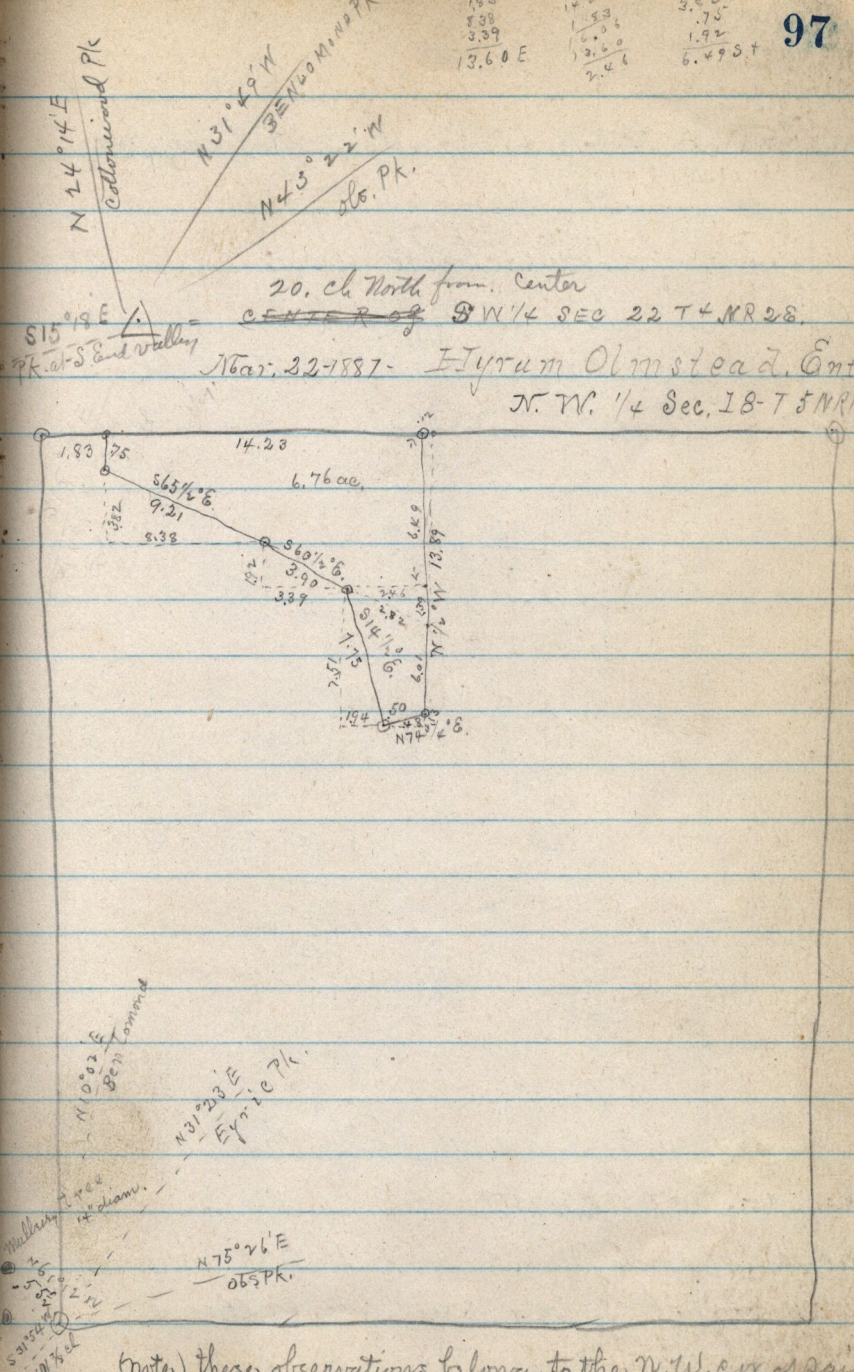

(note) these observations belong to the N.W. cor of said 1/4 Sec

Walnut tree north one in row of 3 8" diam