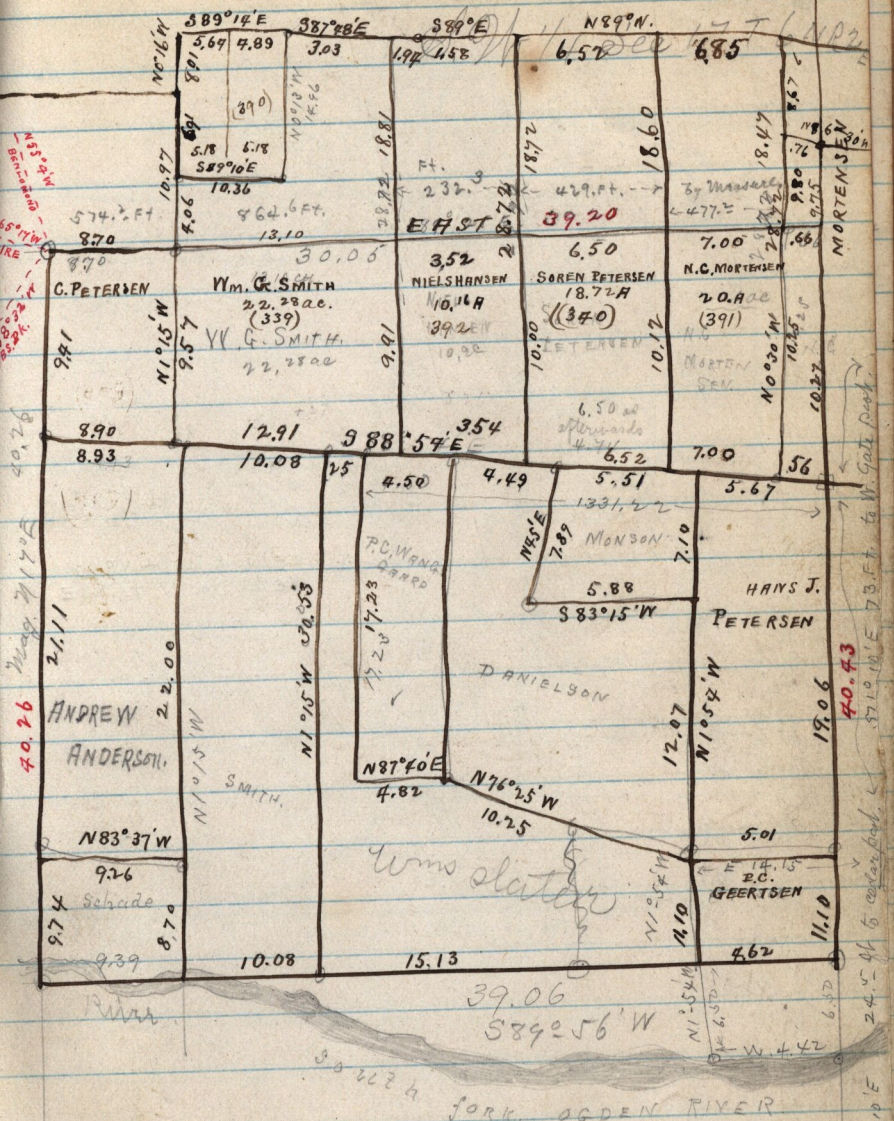

FOR SE 1/4 Sec. 17. See. PAGE 109 this book.
FOR NW 1/4 Sec 17 SEE PAGE 81 " "