


July Aug. 2-1887-

Patented by Barlow Wilson  
Recorded in H 197-

N E 1/4 Sec 25 T6N R2W

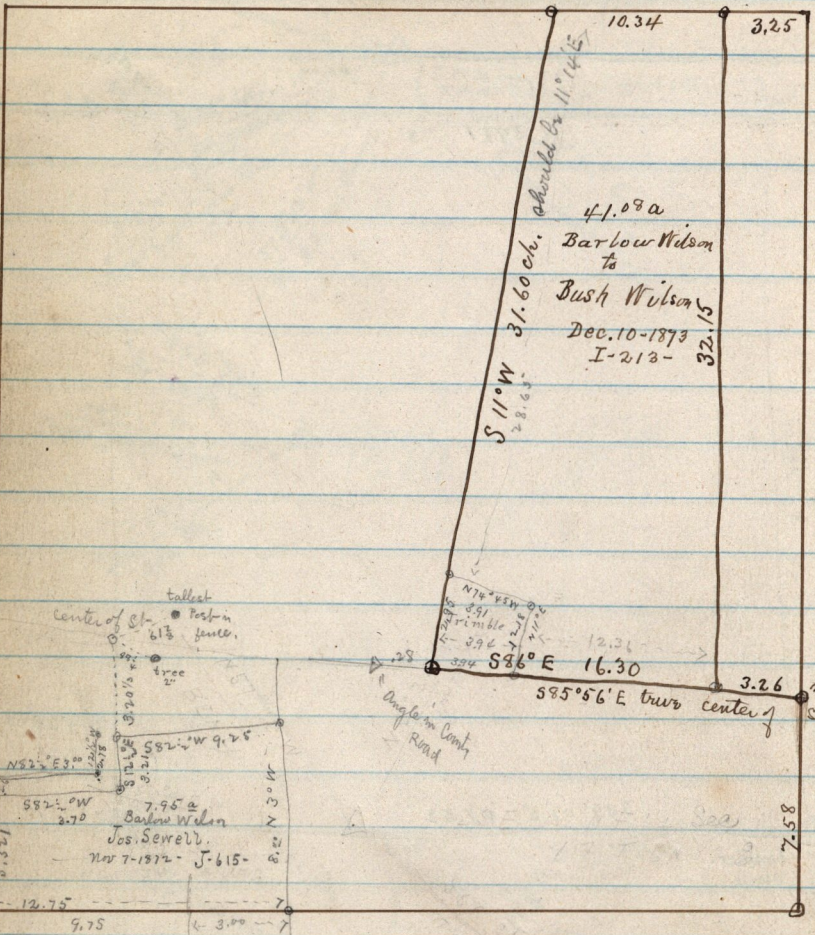

needed from  
 Jos. Sewell  
 Jos. B. Sewell  
 Jan 6-1885  
 not needed