


N. E 1/4 Sec 17

T 6 N R 2 E,

Allanson D. Allen Homestead.

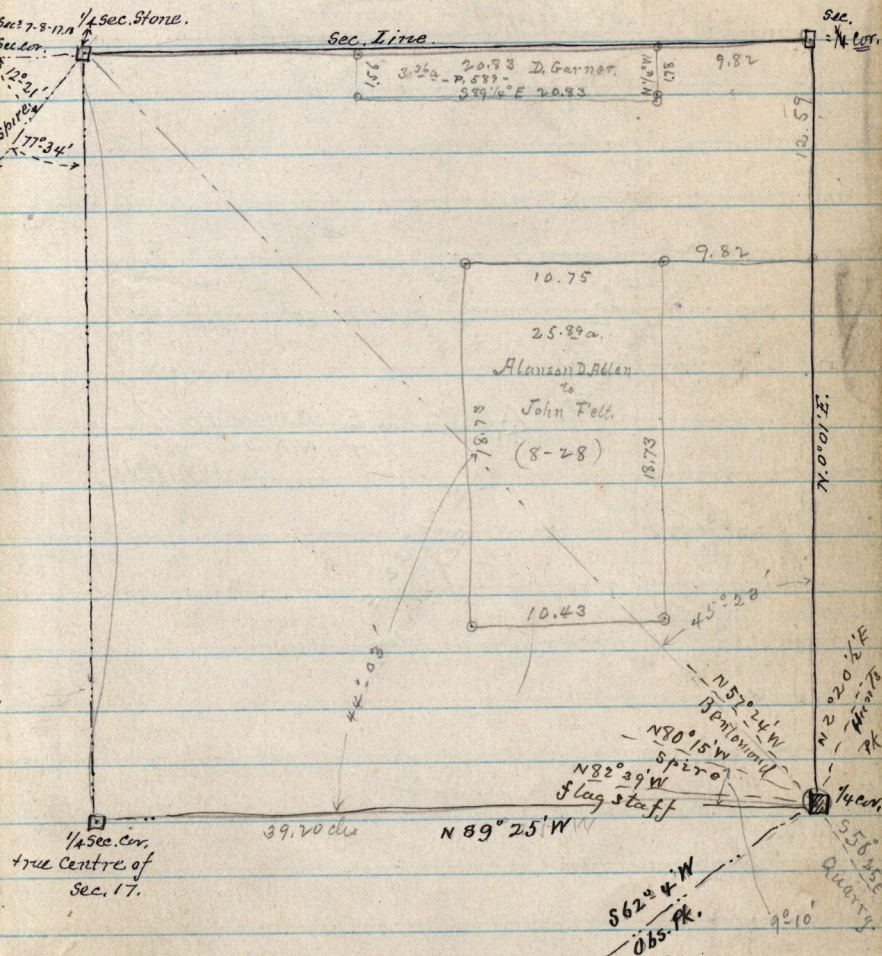

8-25, Allanson D. Allen to John Felt,

Apr. 21-1877. Pt N.E 1/4 Sec. 17. T. 6. N. - R. 2. E. Bsq. 12. 59 chs S. 9 9.82 chs. W. of N.E. Cor. - S. 18.73 chs, - W. 10.43 chs, N 18.73 chs, E. 10.75 ch to sq 25.89 a.