
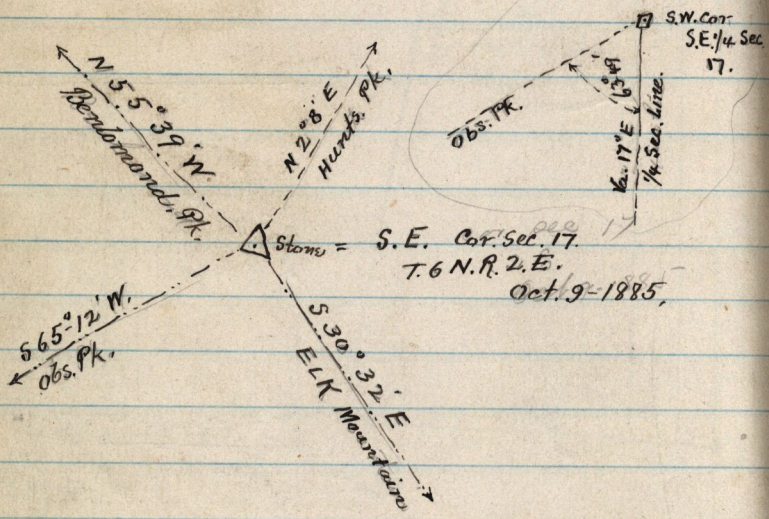


Oct 9 - 1885

108

Seede from Gustaf Anders on part of lot
4 Plat B. Huntersville Plat 12 links wide on

East End

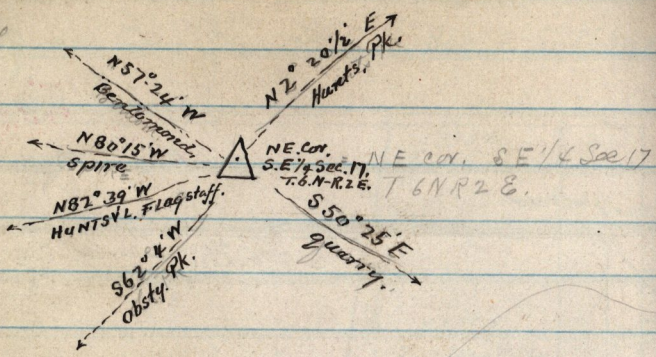

10.56
 6348
 6348
 69428

79
 474
 47
 521 4