Oct 14-1885

S.W. 1/4 Sec 1.
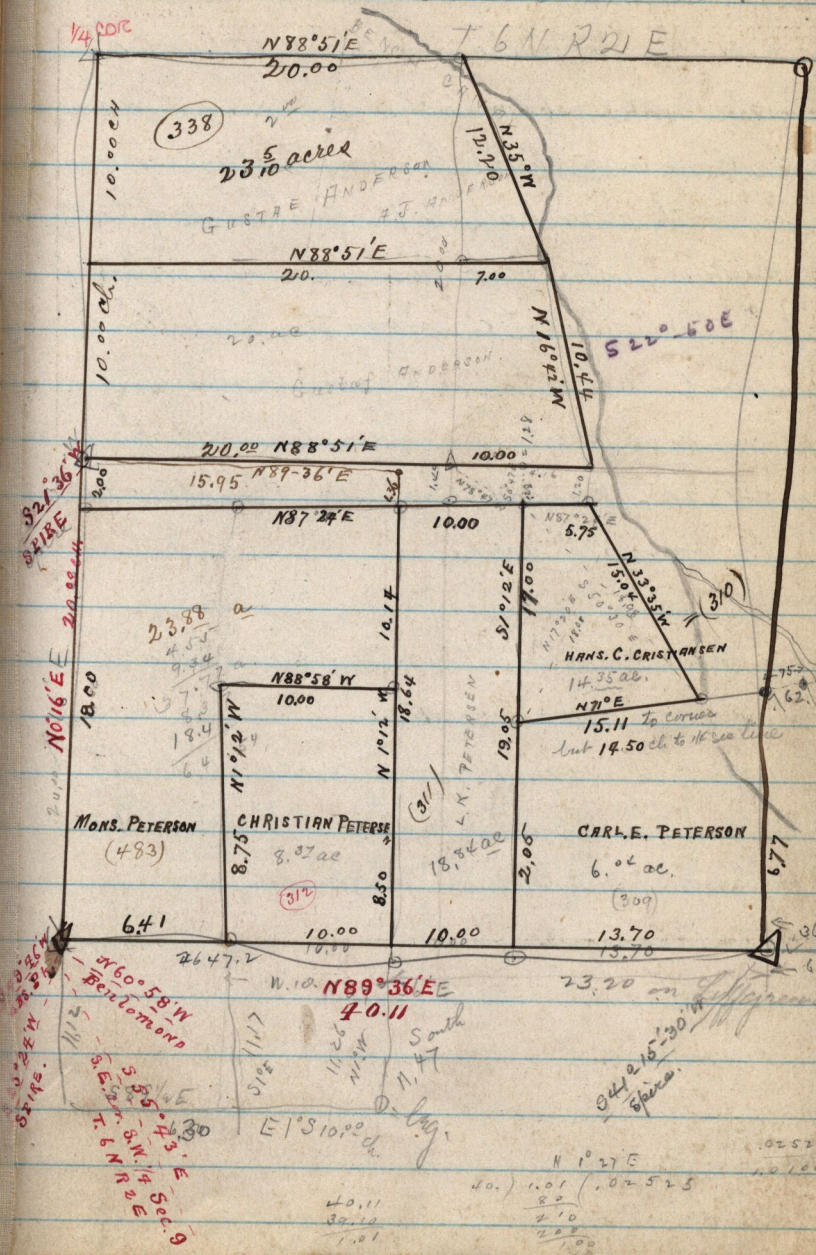
T 6 N R 2 E