Oct 14-1885

S E 1/4 Sec 8 T6N R2E

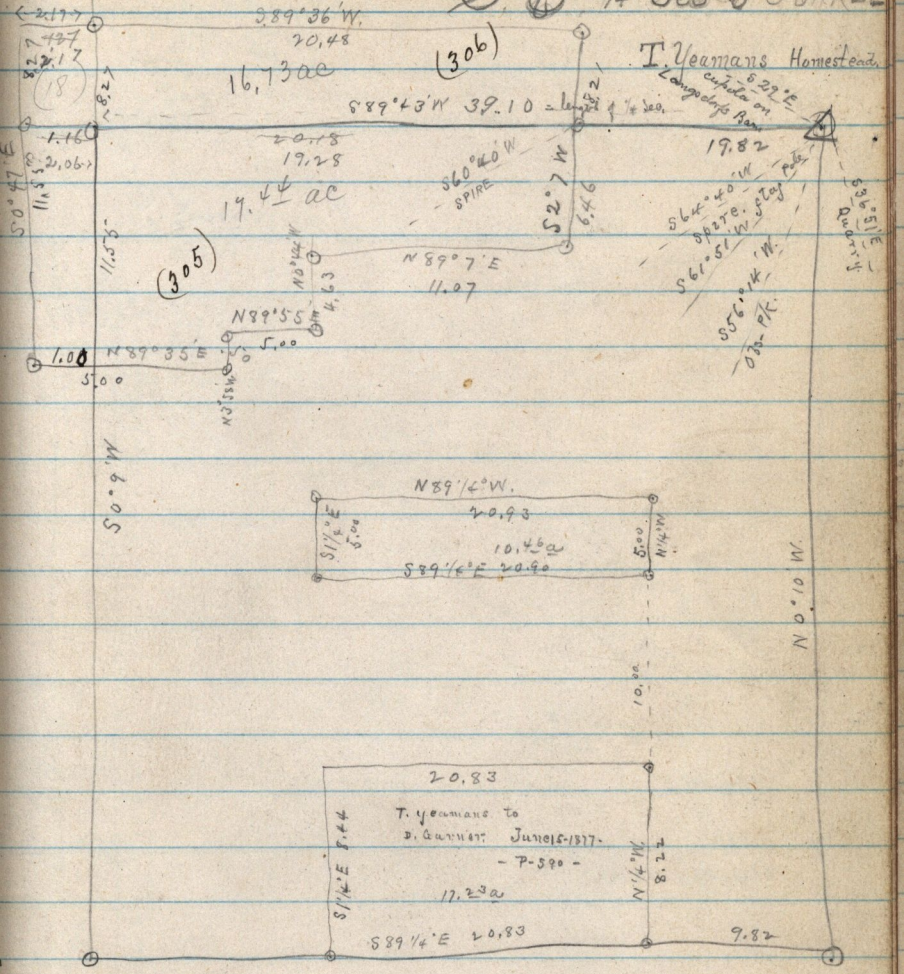

116
90
2.06

20.19
19.28
.90