(see P. page 70)

October 20-1885.

South ½ PRE. EMPTED BY. N. ALLEN BERRETT.
North ½ HOME-STEAD
AMMON CAMPBELL.
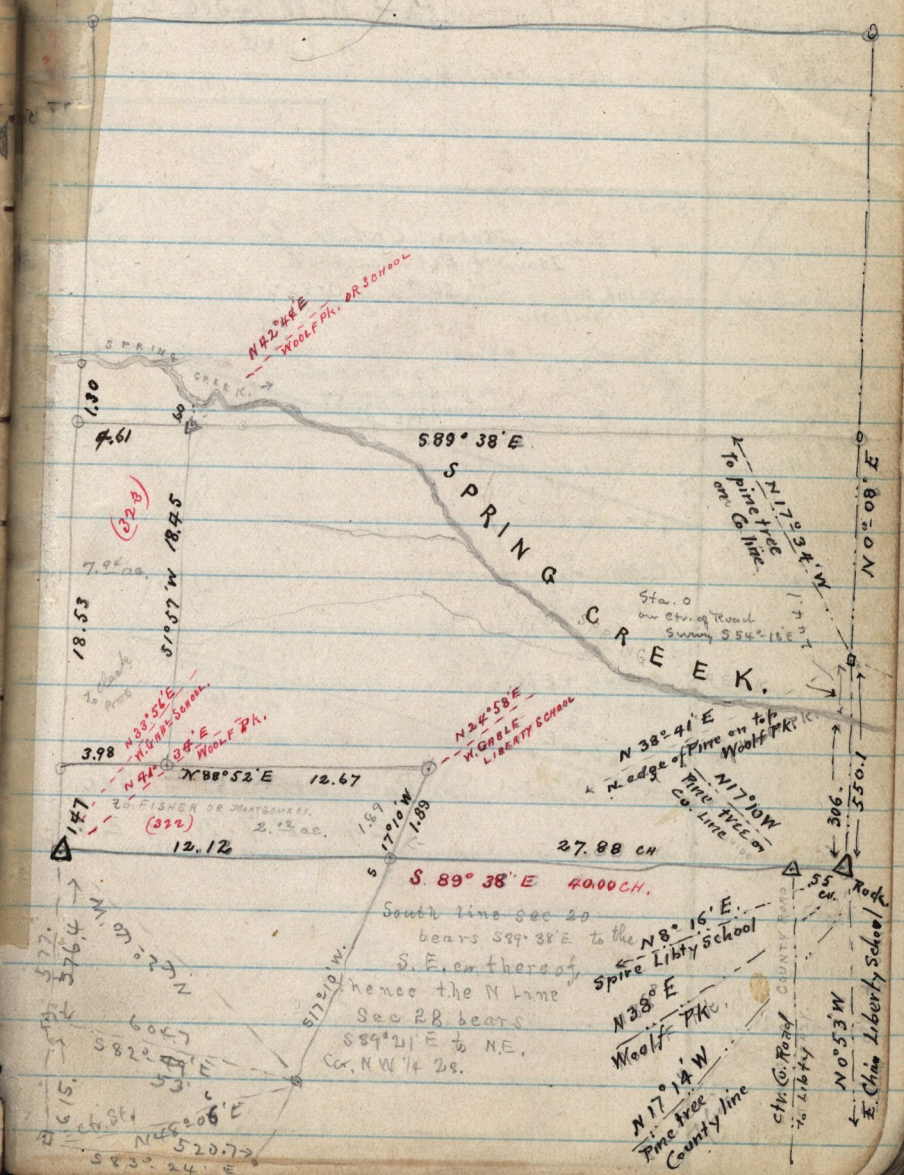
} S W 1/4 Sec 20. T 7 N. R 1 E.