See P. page 70 for more notes
" Plat Book page 54-

October 21st 1885.
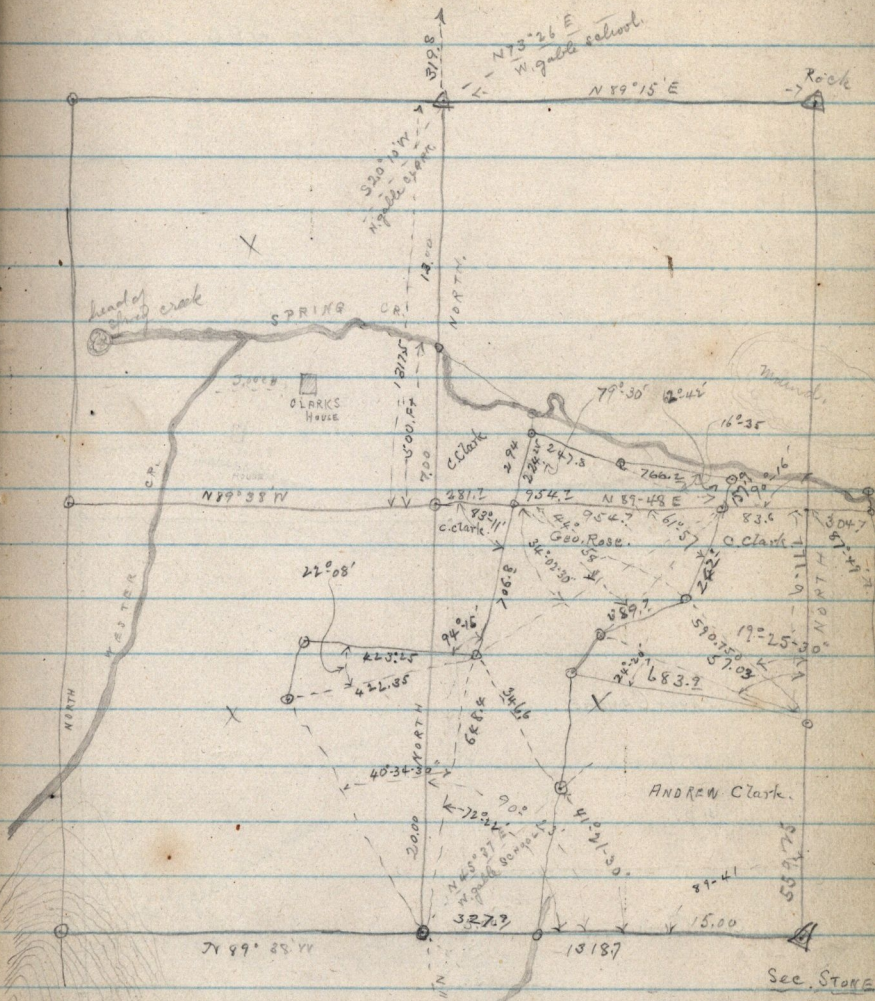
S.E 1/4 Sec. 19 T 7 N R 1 E