November 2nd 1885.
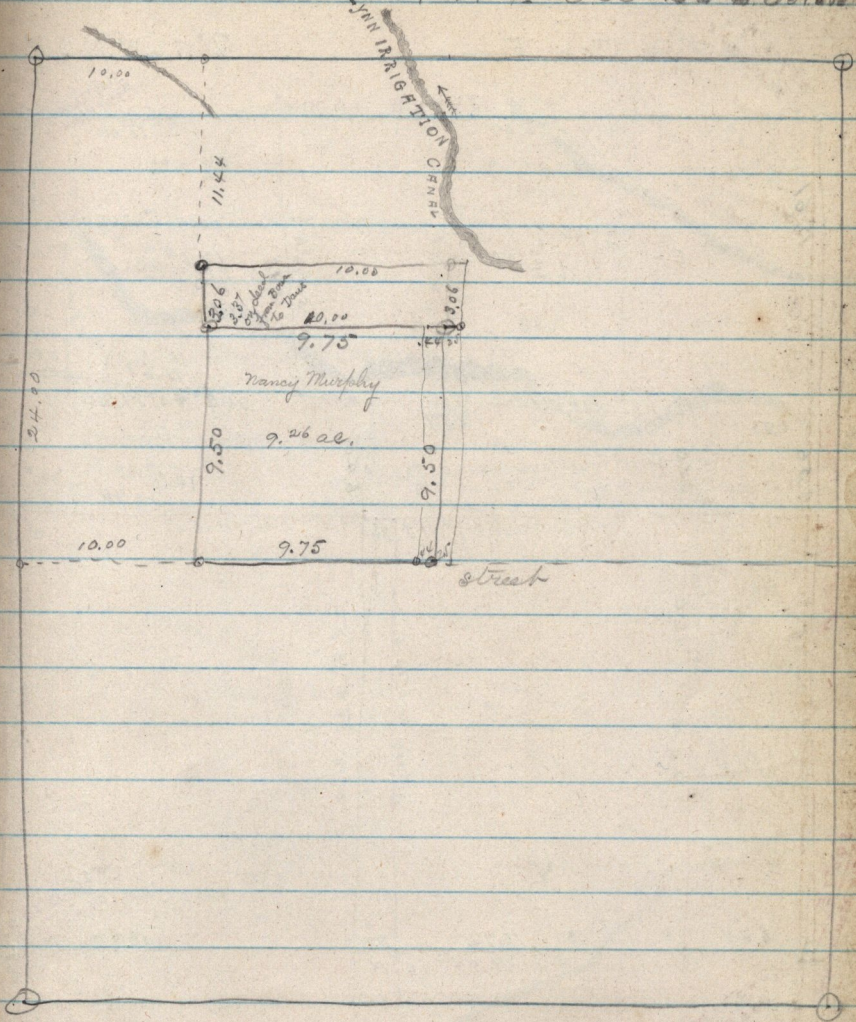
N W 1/4 Sec 21 T 6 N R 1 W