


Nov 3. 1885. Bountville, Utah.

John furnished by CHRISTIAN WANGSBERG T^h 1/4 Sec 12

by JENS FRANSEN

T. C. R. E.

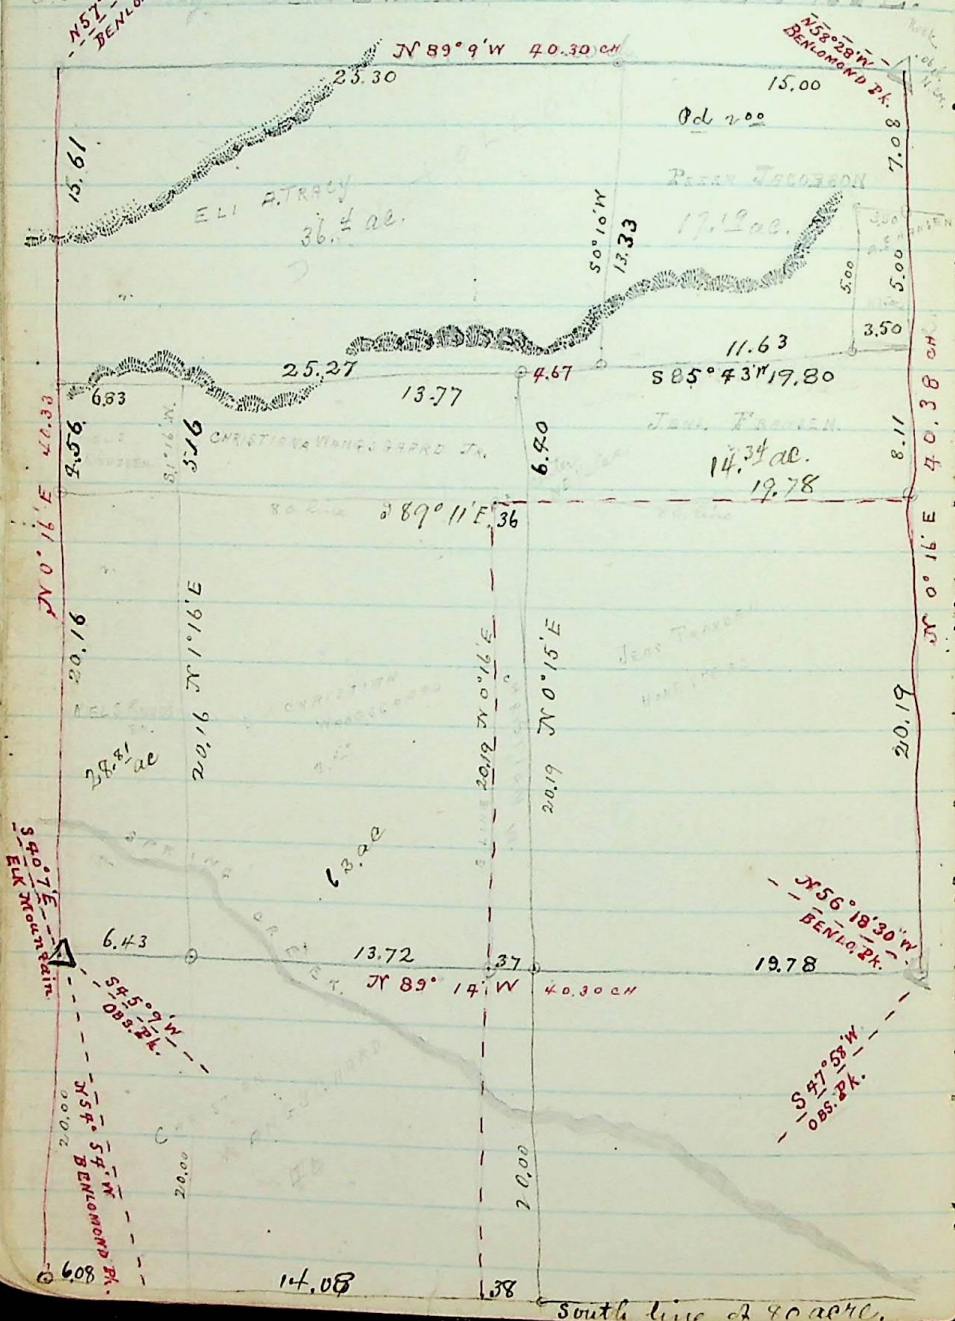

South line of 40 ac 40.