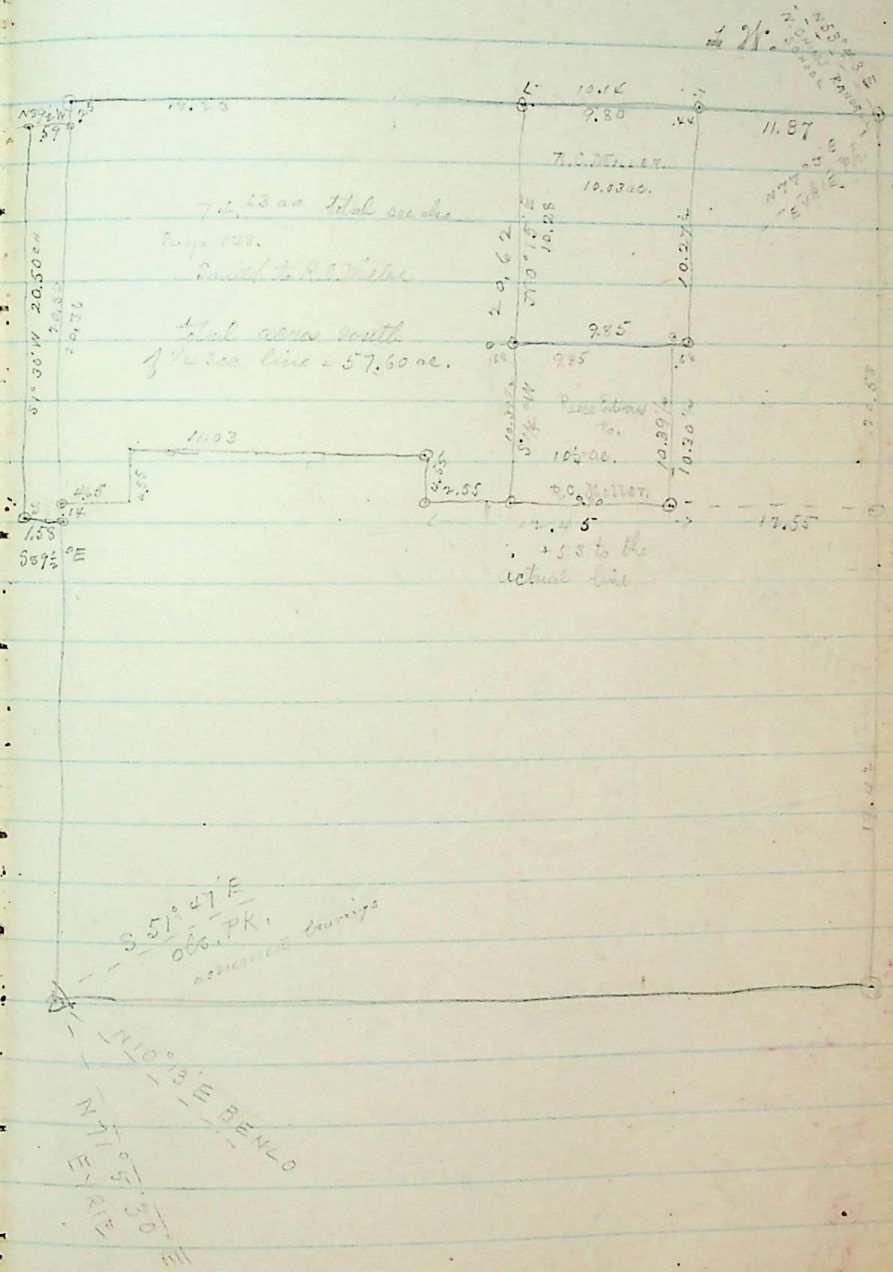S 1/2 1/4 Sec. S. T 6 N R