


November 11-1885

NE 1/4 Sec. 19 T6 NR.

Lot - 1.38.65 a 2 = 38.82 a 3 = 39.24 =

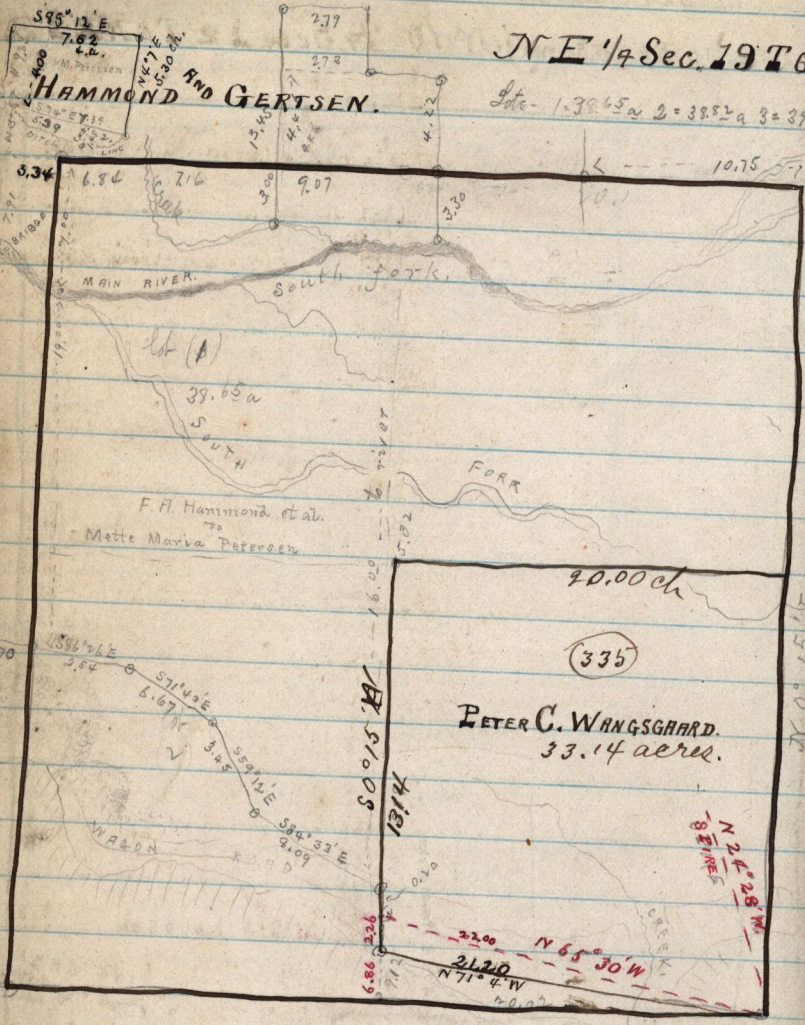

151.0154

N 01° 25' S

31.26
7.65
1.53