


Survey of County Road from Hot Springs westward  
to Salt Lake. on South line of Section 17 -  
By order of Probate Judge who was present.

Section 17 T7 N R 2 W

17

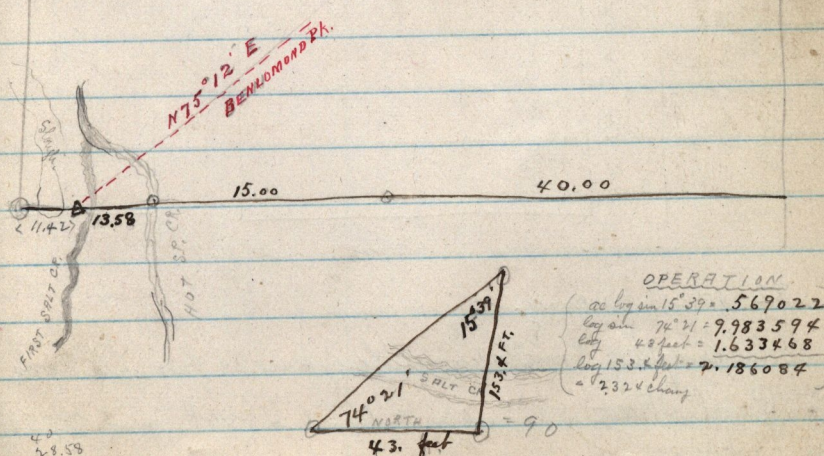

40  
28.58  
1.42

TRIANGULATION ACROSS 1st SALT CREEK.