
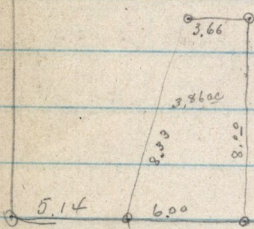


871
382
1253

Nov 19-1885. Survey in Pleasant View.

NW 1/4 SEC 30 T7N R1W

ENTERED by C. THORNTON.

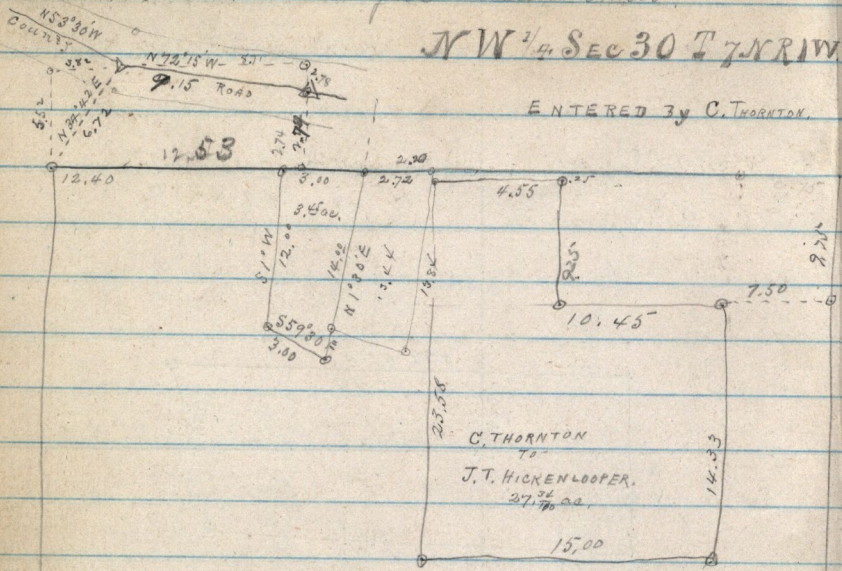






12.53
3.46