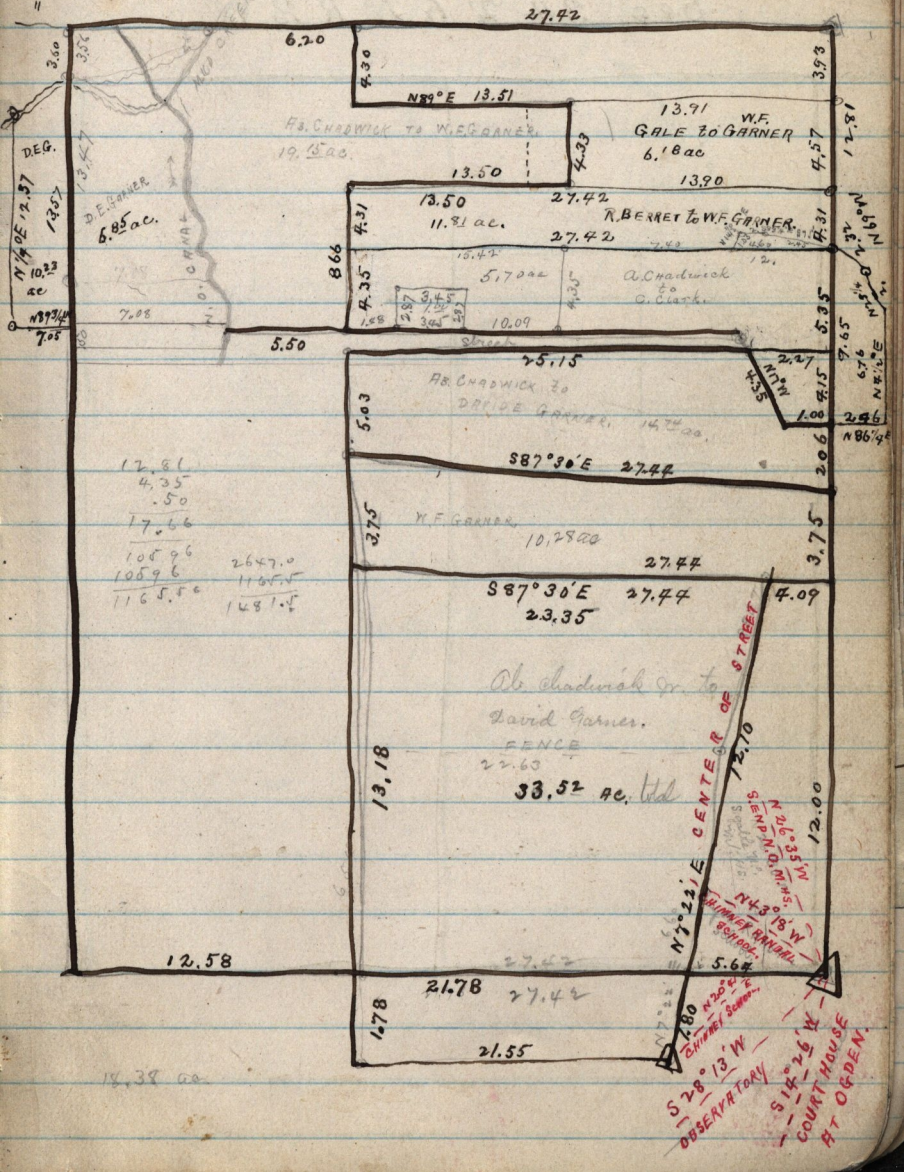N. E. 1/4 Sec. 4 T6NR1W.