February 20-1886

Survey on S. E 1/4 Sec. 30 T 7 N R 1 W.
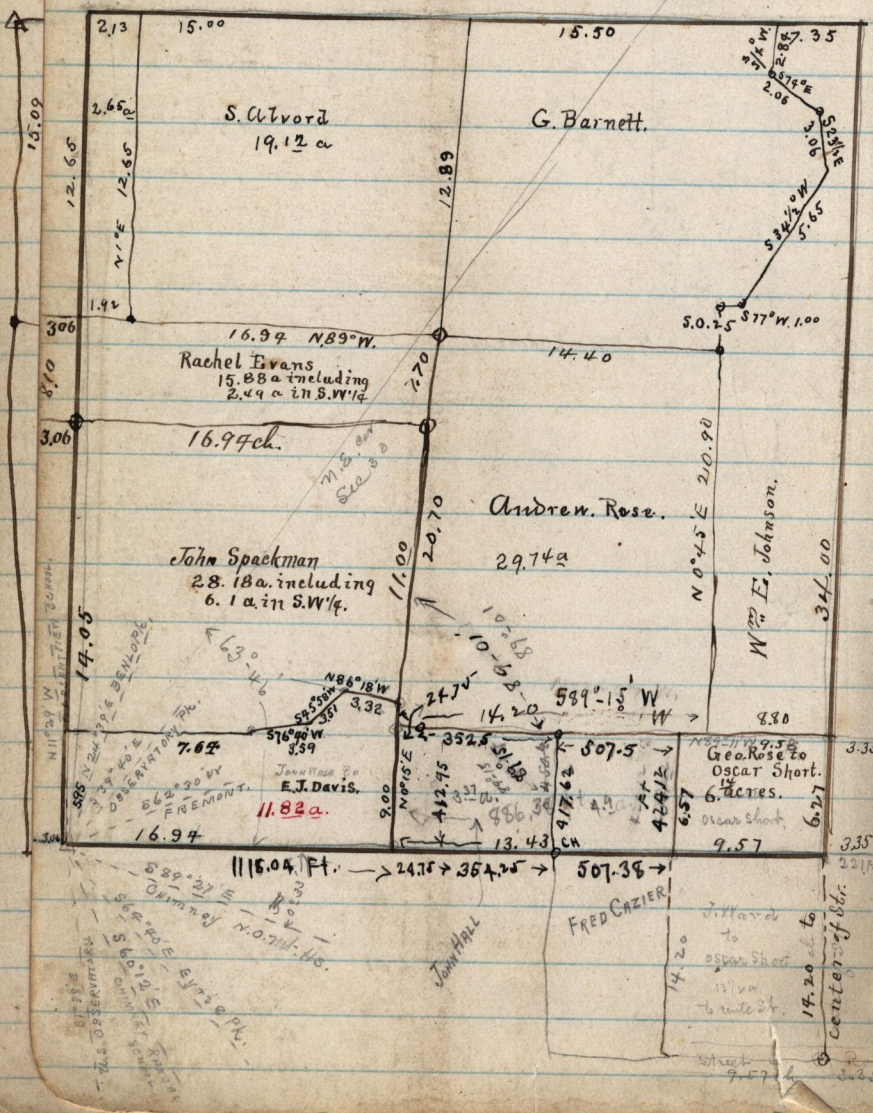
Entered by Geo. Rose.