


X.W. 1/4 Sec 31 T7N R  
1VV

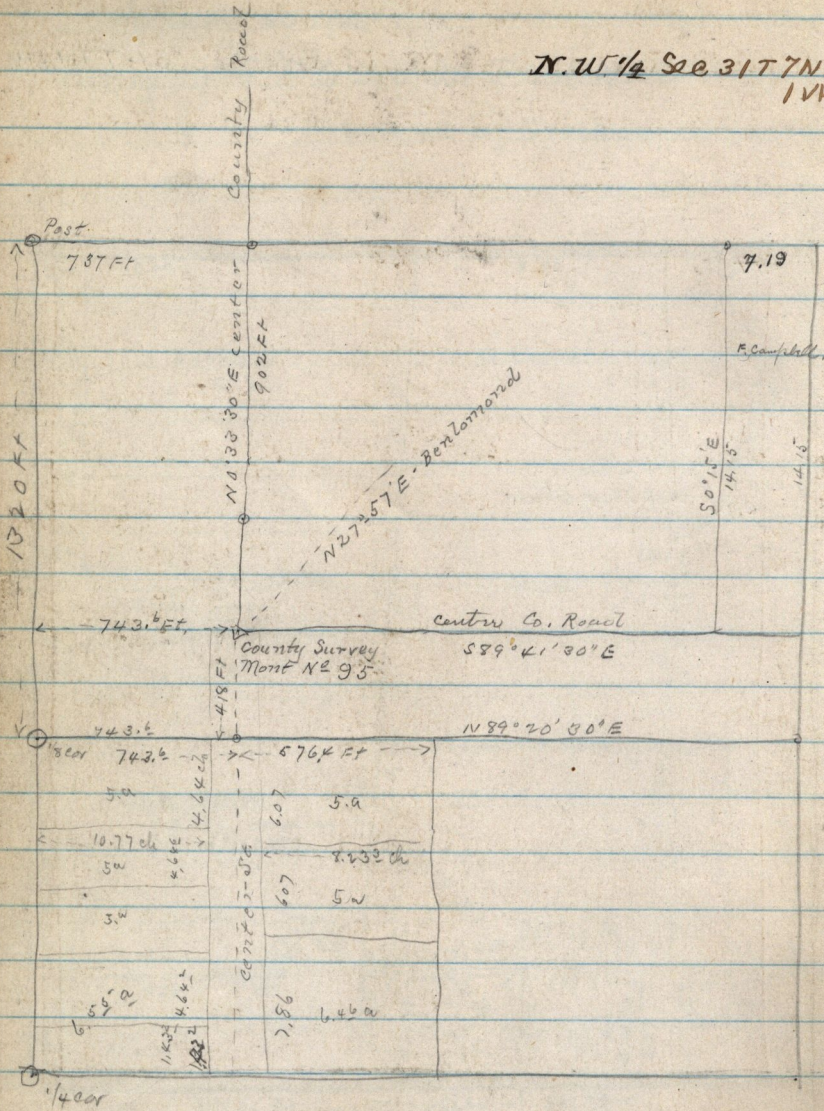

66  
24  
01