


S. E. 1/4 Sec 30 T 6 N R 1 W.
E. Robins

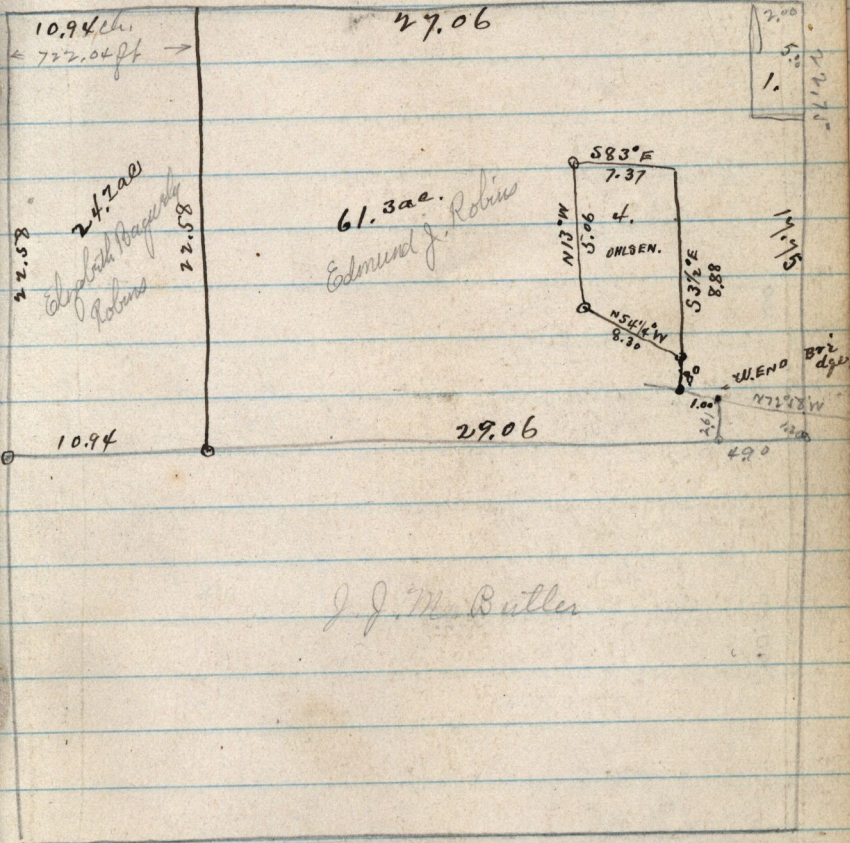

J. J. Mr. Butler