March 22-1886.

Survey of Samuel Gate's Estate.

N. W. 1/4 Sec. 17 T. 6 N.
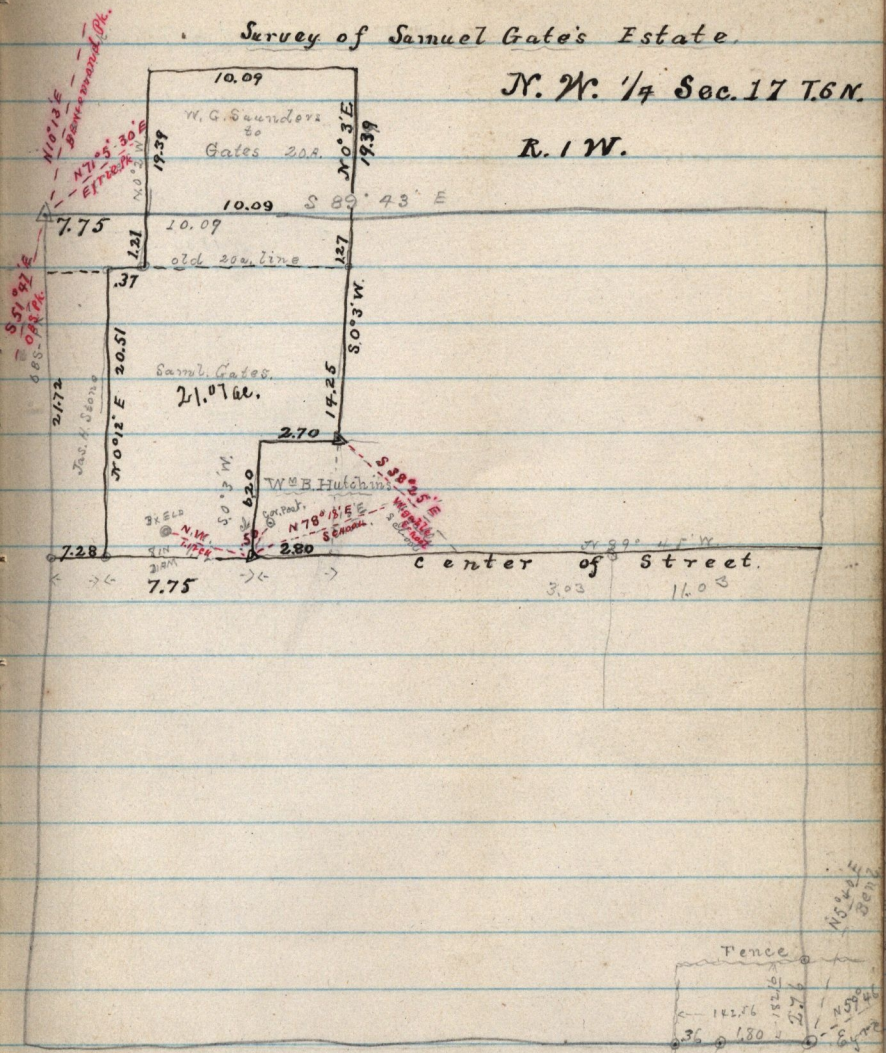
R. 1 W.