N.W.¼ Sec 25 T 6. N R 2 W.

Geo. C. Wilson Patentee.

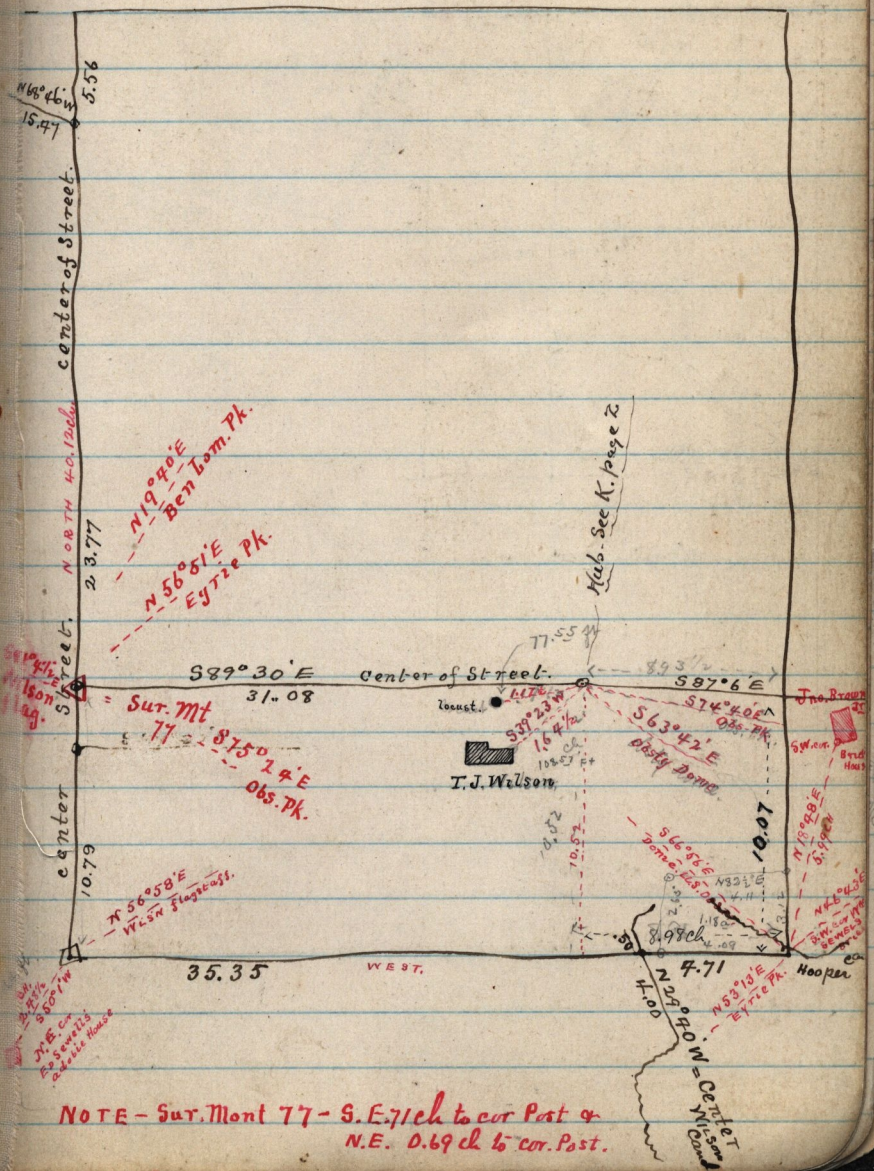

NOTE – Sur. Mont 77 – S.E. 7/10 ch to cor Post &
N.E. 0.69 ch to cor. Post.