


$$\begin{array}{r}
 24 \\
 2 \\
 \hline
 26 \\
 299 \\
 111 \\
 \hline
 824
 \end{array}$$

N.W. 1/4 Sec 21 T6 N R14 W

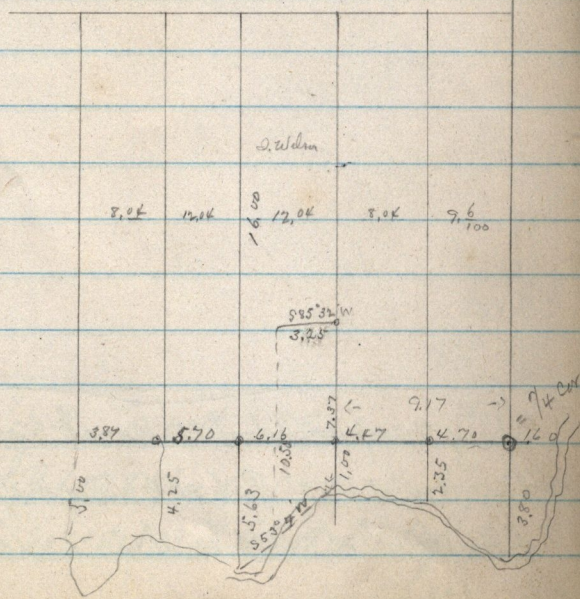

$$\begin{array}{r}
 4.16 \\
 4.16 \\
 \hline
 8.32
 \end{array}$$