


July 21-1856

South West  $\frac{3}{4}$  Sec. 28-T 7 N R 1 E

S. 0° 21' W. 40.60 ch.

Sec. Line

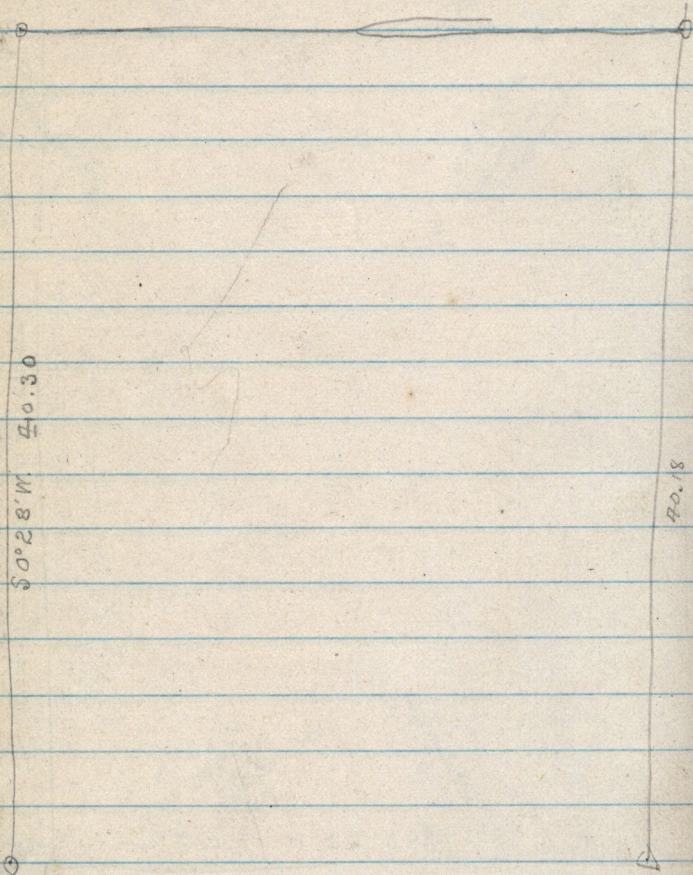

S 0° 28' W 40.30

40.18