


August 8-1886

Ass L. Child to Andrew Patterson.
6 acres.

South east-quarter
Sec 6 T5N R1W

South East 1/4 Sec 6
T5N R1W

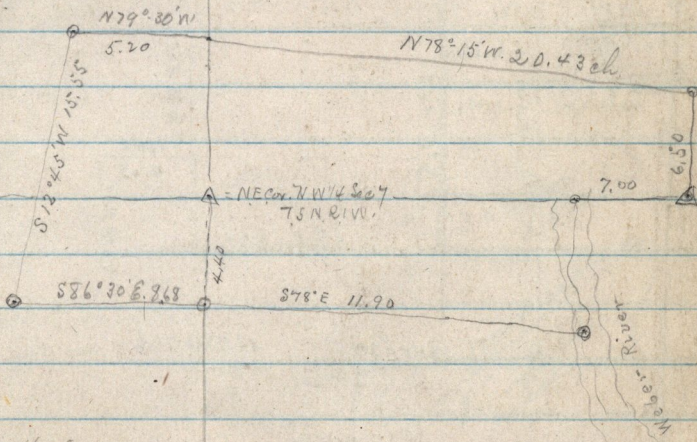

NW 1/4 Sec 7
T5N R1W

NE 1/4 Sec
T5N R1W