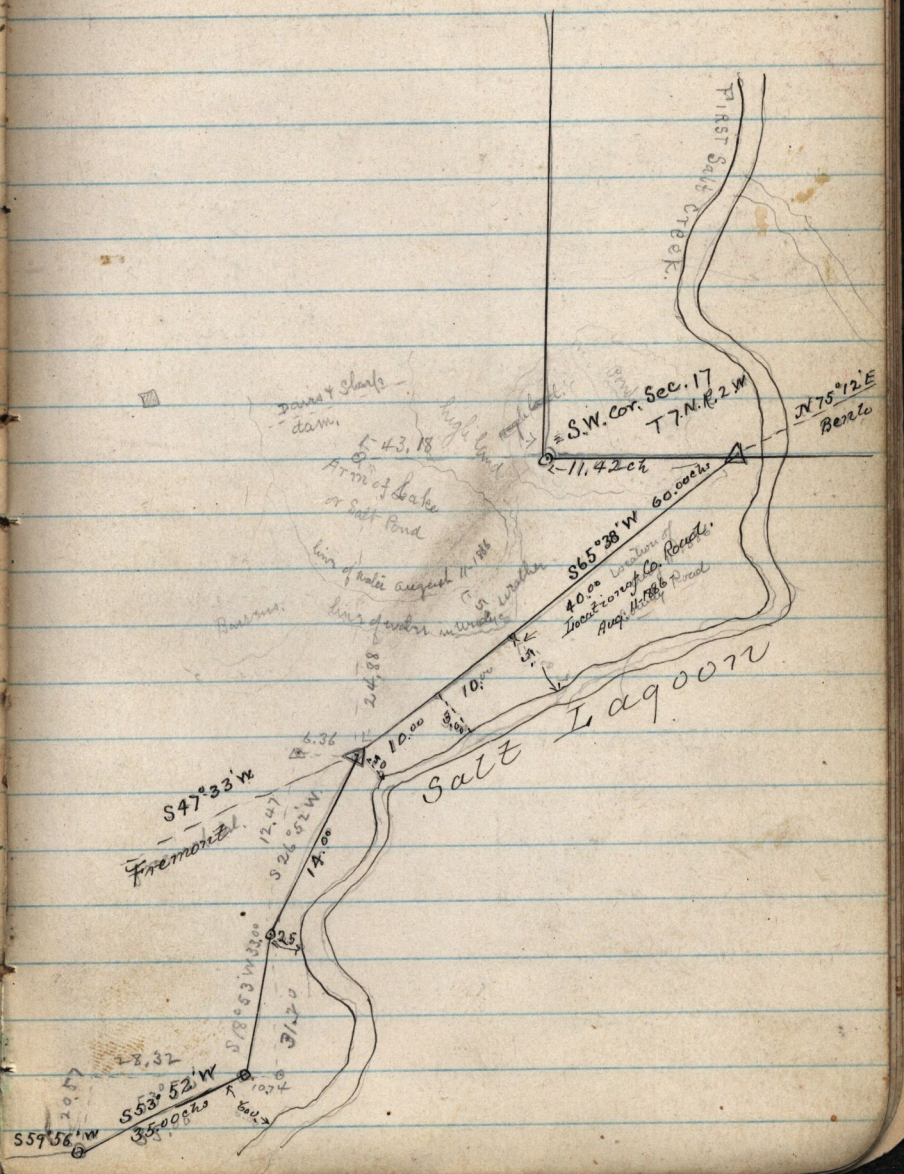
First Salt Creek.
S.W. Cor. Sec. 17
T 7 N. R. 2 W
N 75° 12' E
Bearings
11.42 ch
S 65° 38' W 60.00 chs
40.00
Location of Co. Road
Aug. 11th 86
Salt Lagoon
S 47° 33' W
Fremont
S 26° 52' W
14.00
S 18° 53' W 32.00
31.70
28.32
S 53° 52' W
35.00 chs
S 59° 56' W
Dams & Sluices
dam
Arm of Lake or Salt Pond
Line of water August 11, 1886
Line of water in winter
Location of Co. Road Aug. 11th 86