


October 8-1886-

Survey of N. 2 1/4 Sec 36

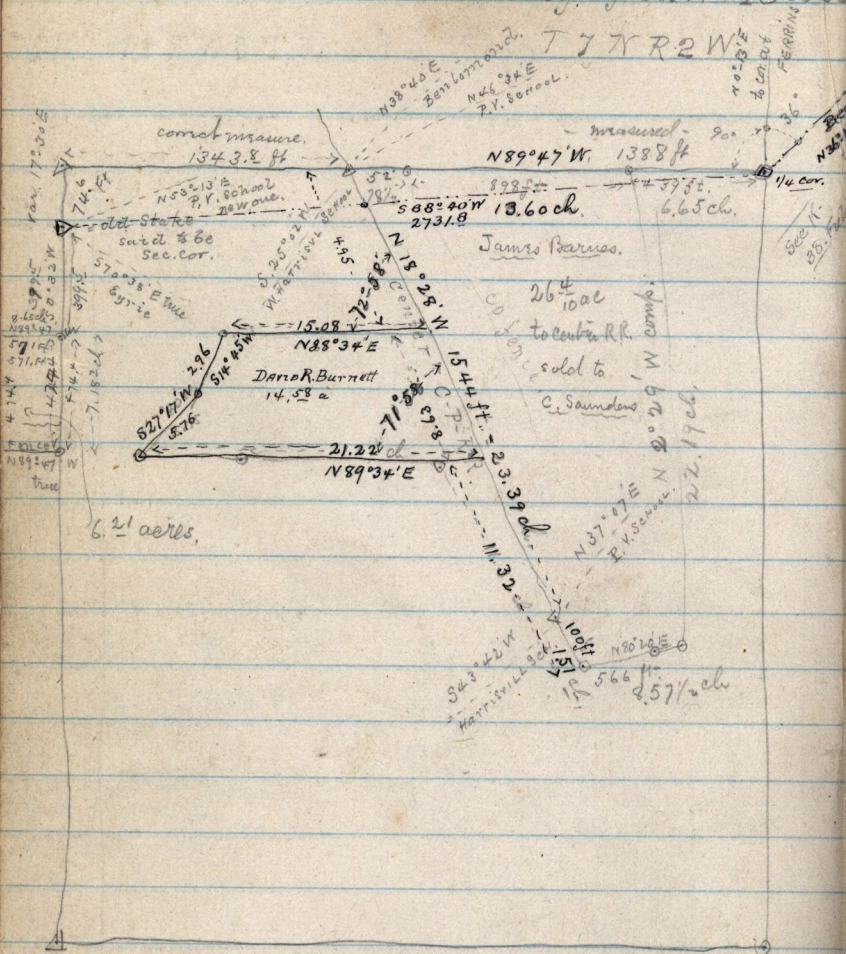

6.21 acres