


Eden.

Garden Valley Nov. 17-1886

S. W. 1/4 Sec 34 T7 N R1E

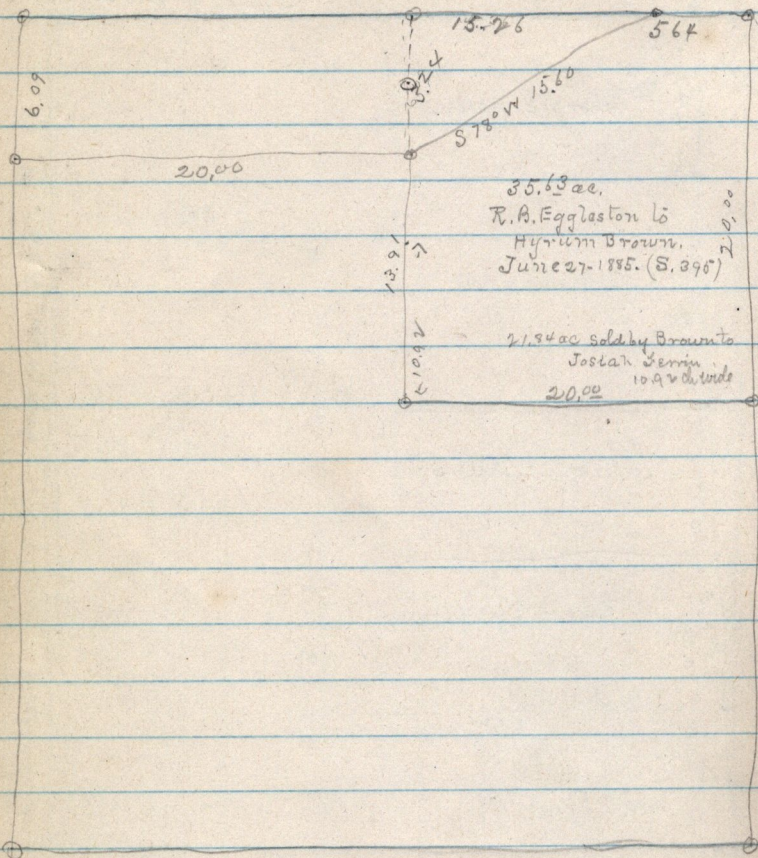

10 1/2 ch wide