


Nov. 17-1886-

S. W. 1/4 Sec 35 T. 7 N. R. 1 E.

Place conveyed by E. B. Fuller
(to Hymen Brown.)

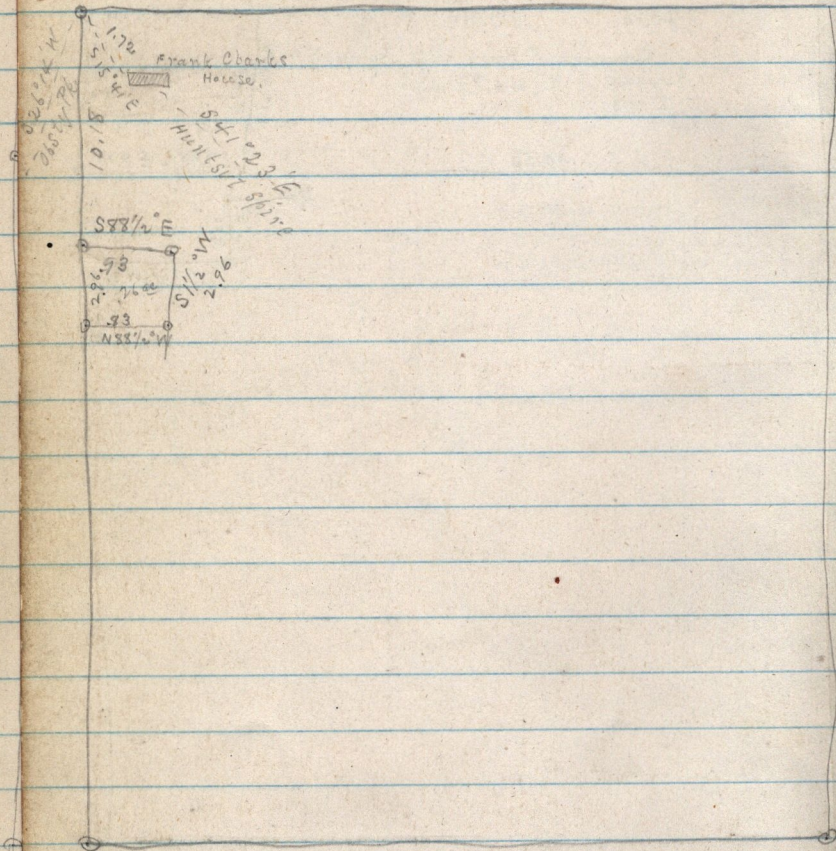

10.9
9.