


008727

40

00349080

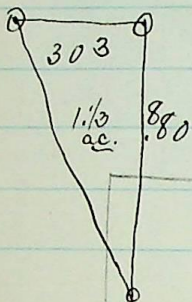

20.28

1.53  
18.75

make Examina  
S.E 1/4

for S.W 1/4 27-76NR 2W

+ S.E 1/4 S.E 1/4 27-

also S.W 1/4 4th 1/4  
26.

S.W 1/4 27-76NR, 2

00862  
80  
58980 = 0019

W<sup>m</sup> me Jarland

50) 60000  
621  
500  
450  
200

00862

2.904

3.03

8712

8712

90  
19  
71  
90

8.79912

303

4.40

12120

1212  
1.33320

Mark Murphy

206

206

1236

412

42406

36  
62.2436

25

224

369

5531

1000

325

6.22

6.84

2.00

2.7

6.34

7.10