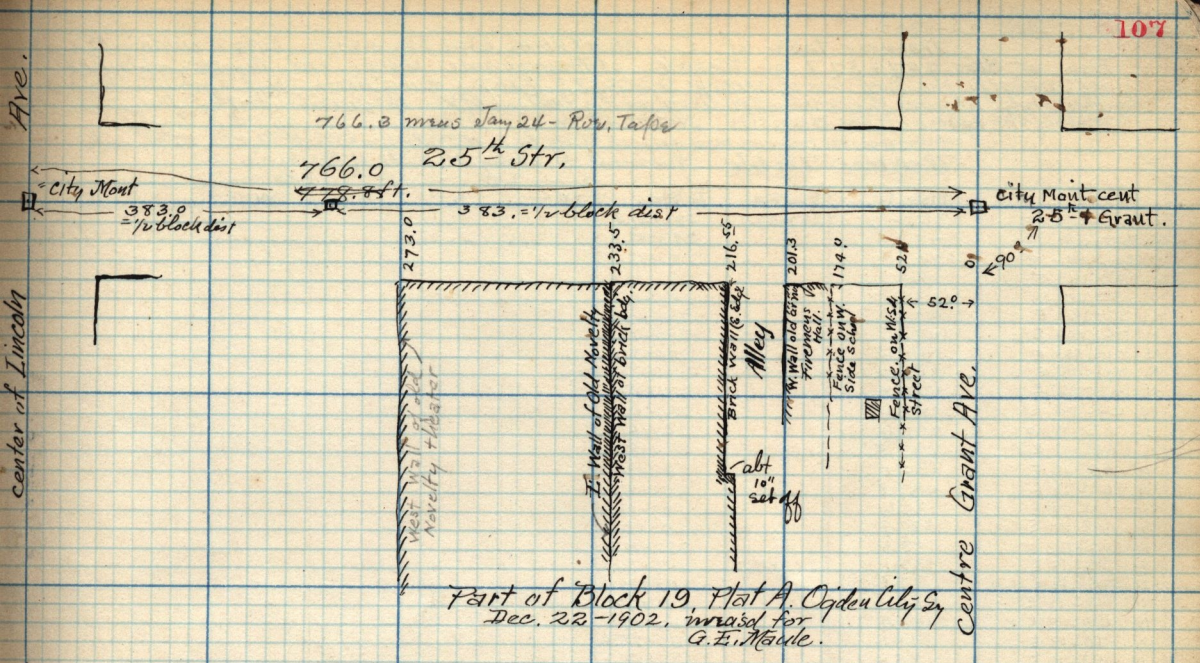


Part of Block 19, Plat A Ogden City Survey
Dec. 22-1902, mease'd for G.E. Maule.

34-240 - G.H. Matson - M. & C.H. Kircher to Geo. E. Maule - Ap. 4-1900 -
Pt. Lot 7. Blk 19. P.A. - O.C.S. Beg. 105 3/5 ft. E. from N.W. Cor. said Lot
E 59.7/5 ft. - S 8 R. W 59 7/5 ft - N 8 R. to Beg. (See page 118 this book)

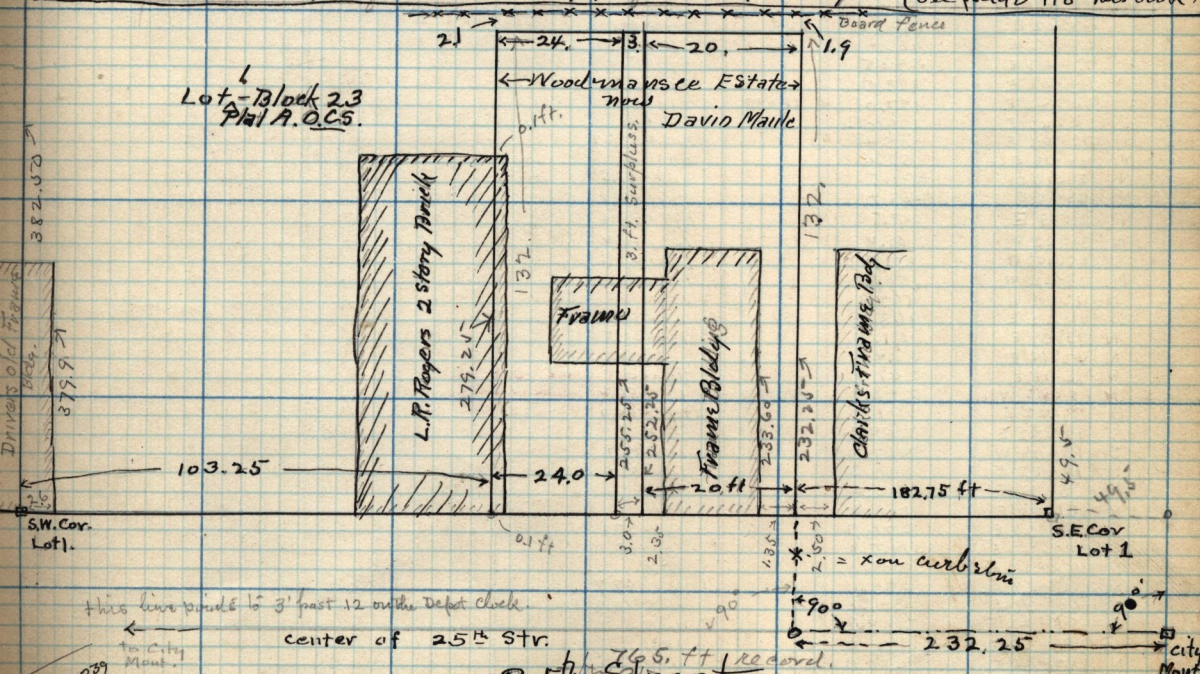


25th Street

copy of plat made by Parker for. Woodmansee Estate.

I verified the East line of the above survey and found the stakes set by Parker practically correct. and made a X on the curb stone opp. S.E. Cor