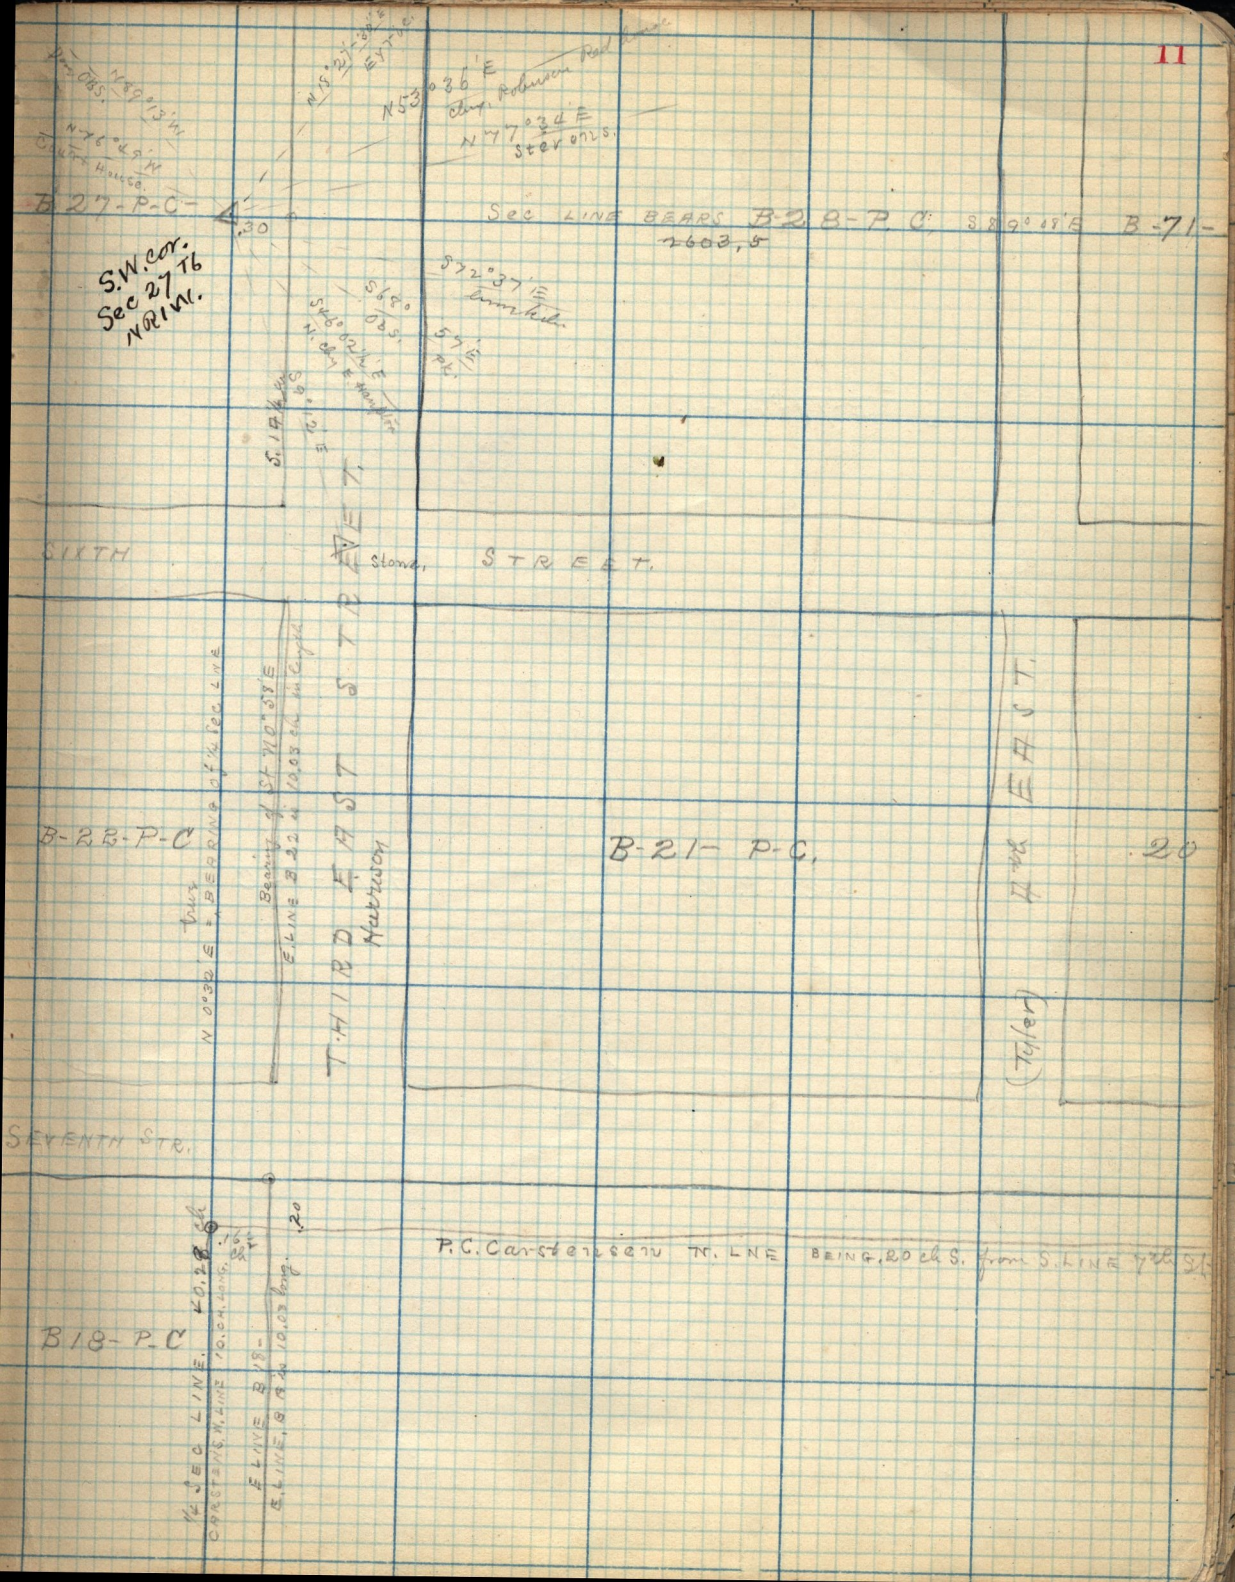
N 89°13' W
N 76°49' W
Court House
N 15°27'-30" E
Eyr-Oc
N 53°36' E
Clay, Robinson Red house
N 77°34' E
Stevens
B 27-P-C
.30
Sec LINE BEARS B-28-P.C. S 89°08' E B-71-
2603,5
S.W. cor. Sec 27 T6 N R1 W.
S 72°37' E
S 68° Obs.
S 46°02½' E
N. clay E. Hampton
S 9°12' E
S 17½ W
SIXTH
Stone
STREET.
THIRD EAST STREET
Harrison
N 0°32' E = BEARING of ¼ Sec. LINE
Bearing of St N 0°58' E
E. LINE B 22 in 10.03 ch in length
B-22-P-C
B-21-P-C.
.20
(Tyler) 4th EAST.
SEVENTH STR.
.20
P.C. Carstensen N. LNE BEING .20 ch S. from S. LINE 7th St.
B 18-P-C
¼ SEC LINE 40.28 ch
CARSTENS N. LINE 10 CH. LONG.
E LINE B 18-
E. LINE B 18 in 10.03 long.