


Plat of Cross Street. in OGDEN City

Jan. 26 - 1903

↑
North

T.G-N-R.I.W.

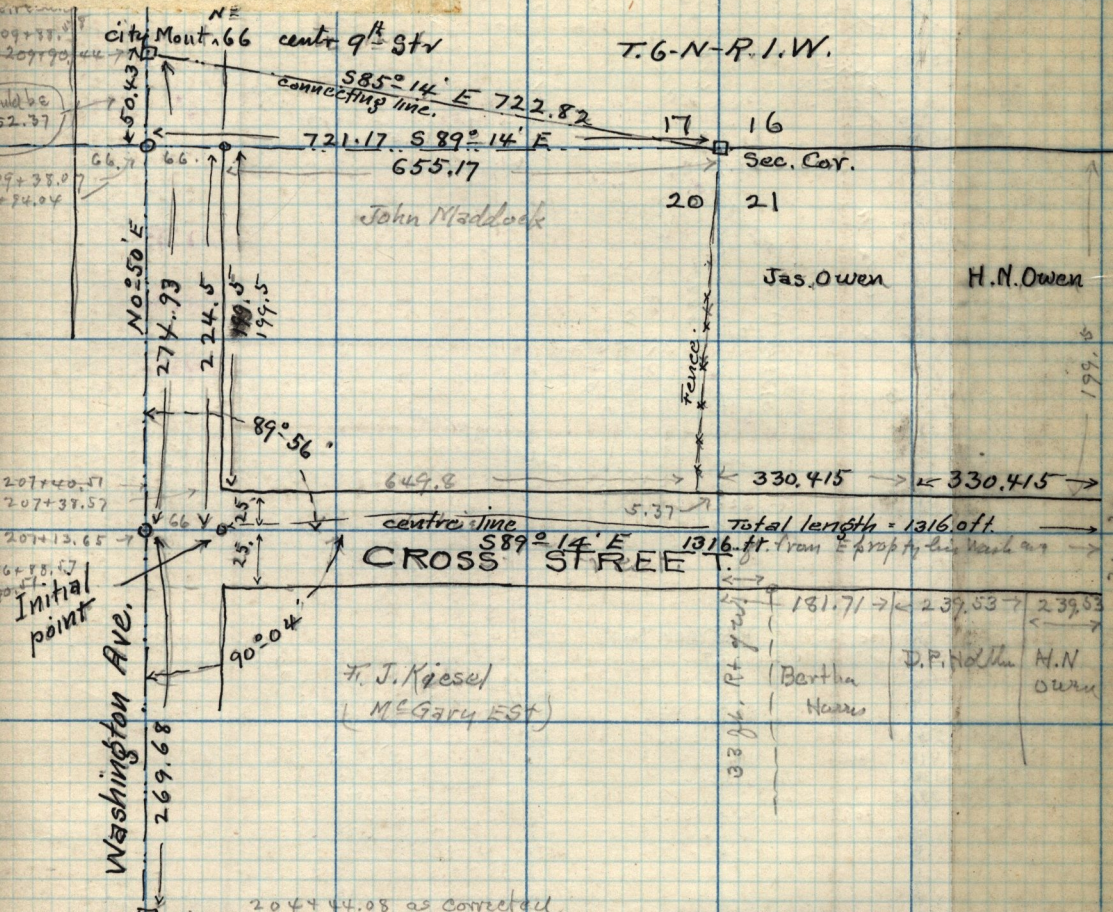

Initial point

Washington Ave.

F. J. Kiesel
(McGary Est)

33 ft. R + 2 ft. L

Bertha Harris

D.P. Holm H.N. Owen

Cross Street was dedicated by the land owners and accepted by Ogden City Nov. 24 - 1902

Recorded in plat Book 39 -
page 193 - County - Record Office