March 11-1903.
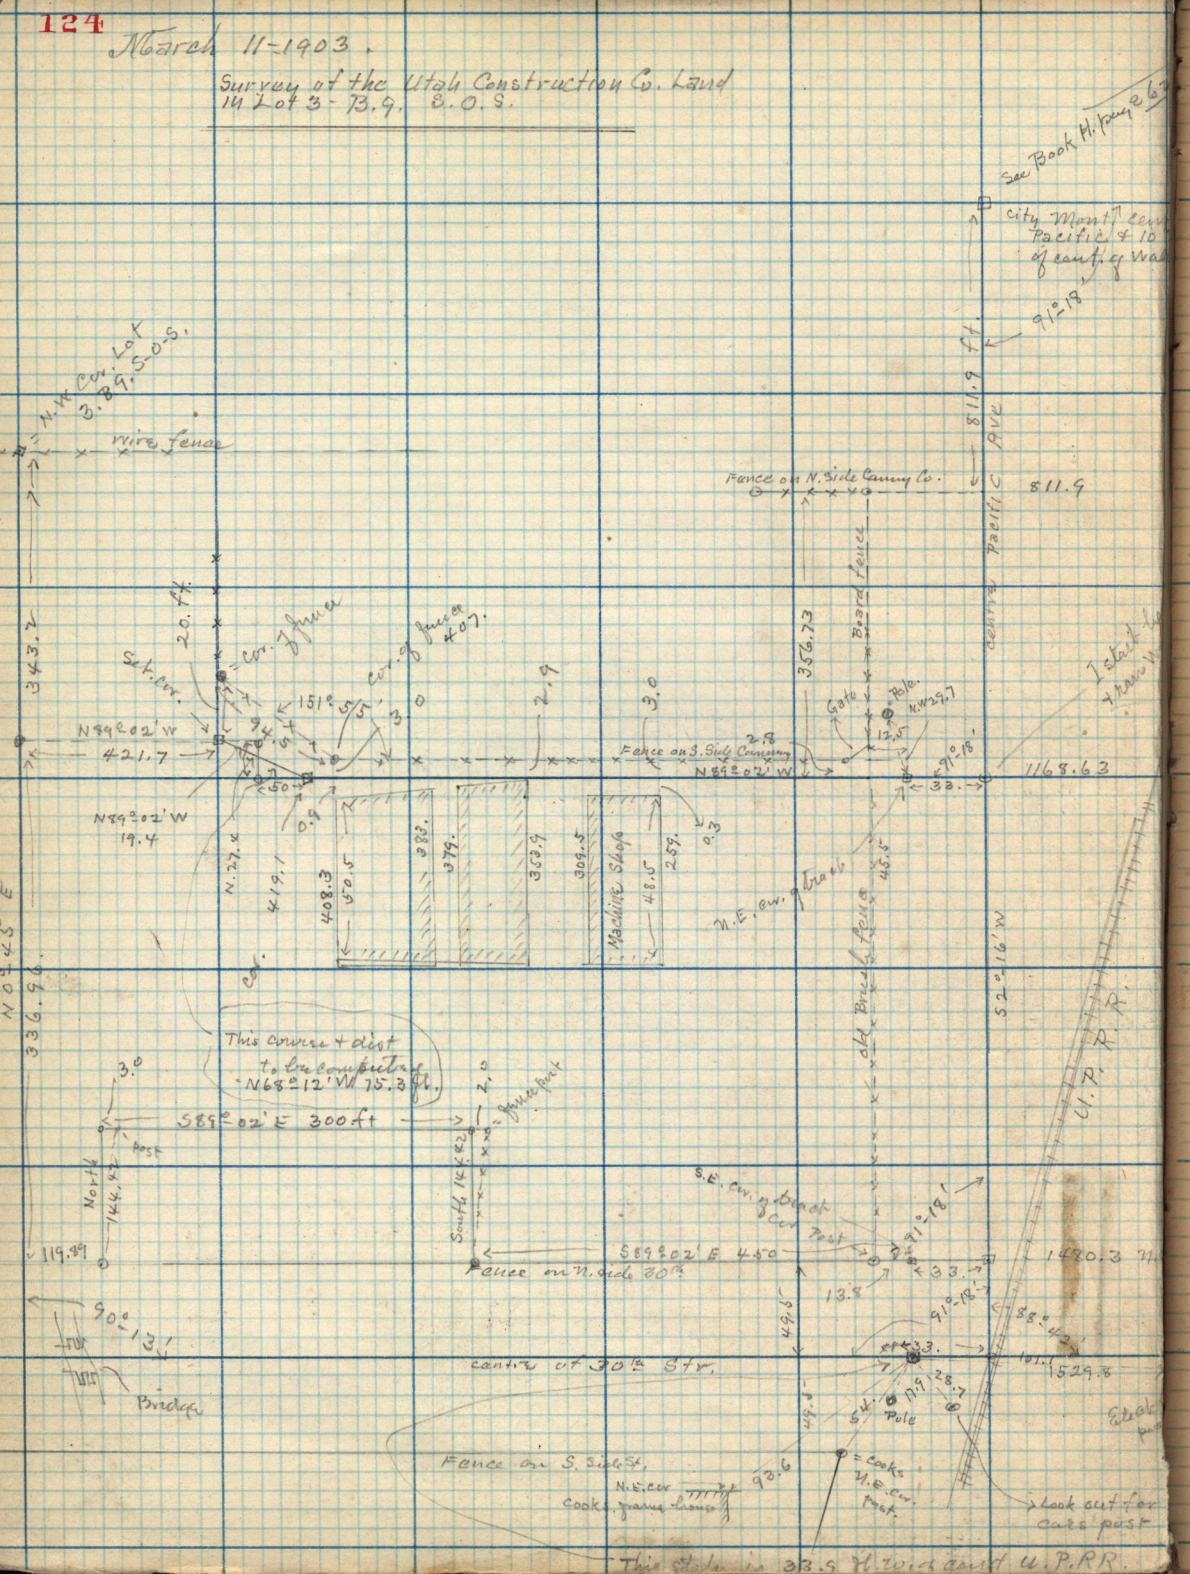
Survey of the Utah Construction Co. Land
in Lot 3 - 13.9. S.O.S.